IREDELL COUNTY HEALTH DEPARTMENT

STATESVILLE 704-878-5305 MOORESVILLE 704-664-5281

IMPROVEMENT PERMIT / CERTIFICATE OF COMPLETION / OPERATION PERMIT / EXISTING SYSTEM INSPECTION

PROPERTY DESCRIPTION NO. 20138 DATE March 31, '95 TAX MAP NO. part of 25A51 Watershed: ☑ Yes ☐ No

OWNER OR CONTRACTOR Krom Financial Services PHONE: Business 664 3671 Home 4638-98-5320

ADDRESS 19 Yacht Cove Rd, Mooresville

LOCATION Faith Rd TR Cornelius Rd TR Mills Pond Rd 5th left on left

SUBDIVISION Mills Pond Head BLOCK / SECTION ____ LOT 23 LOT AREA 1.64ac SITE CLASS. 5 per 1956 DESIGN FLOW 360 gpd L.T.A.R. .3

Septic Tank: 1600 Pond Gallons; STB 825 Date 9/10/95

Pump Tank: ____ Gallons; PT ____ Date ____

Pump Make: ____ Model ____ Serial No. ____

Nitrification Field: No Fields 1 Square Feet 900 Linear Feet 300

No Lines 3 Trench Width 36" Max Trench Bottom Depth 36" Gravel Depth N/A

☑ New System ☐ Repair System Type: I, II, III, IV, V, VI

System Description: Gravity Infiltrator

Repair System Description: GRAV/Pumped Inf. Trator

Maintenance Agreement Required: ☐ Yes ☑ No

☑ House/Mod. Home No. Bedrooms 3

☐ Mobile Home No. Bathrooms 2

☐ Business No. Employees ____

☐ Other ____

☐ Slab ☑ Crawl Space ☐ Basement w/plumbing ☐ Basement wo/plumbing


Water Supply: ☑ Individual ☐ Community ☐ Public

Comments:

Comments: Ready to Issue

1" = 50'

INITIAL SITE SKETCH

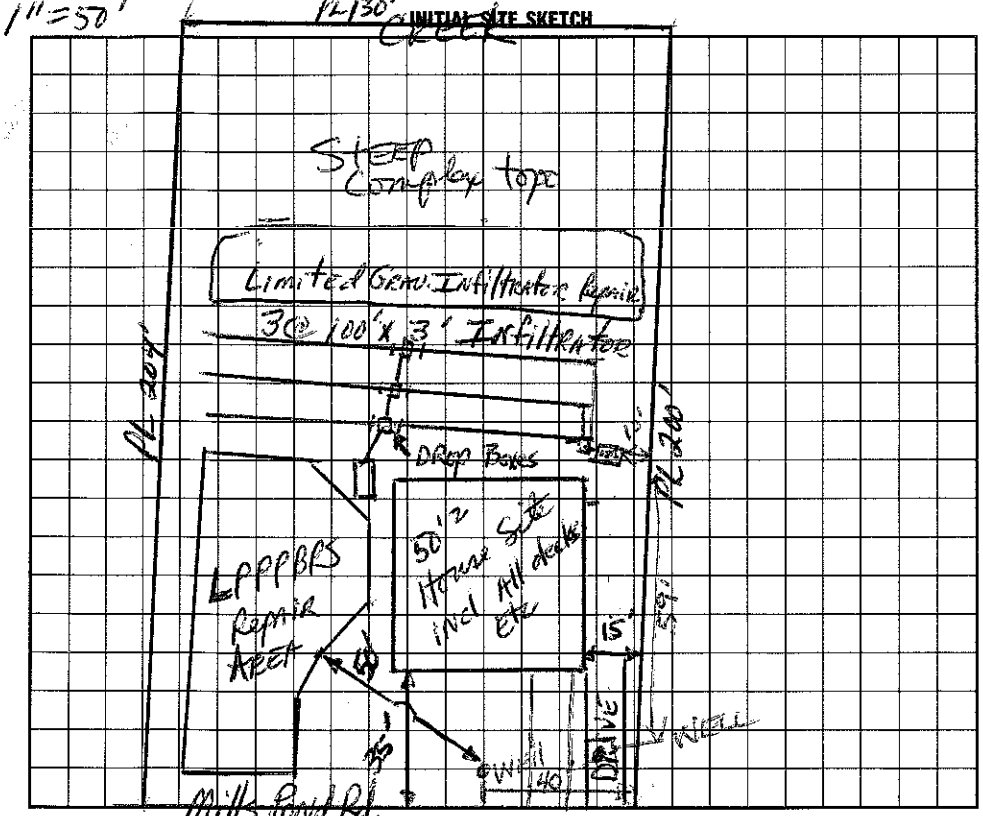

AS BUILT SKETCH

I understand that this permit can be suspended or revoked if any false information is supplied toward securing the permit/any unauthorized changes are made to the site/any unauthorized changes are made in the installation of the system. Improvement Permit is valid for 60 months from date of issuance.

Signed: ____ 7/17/95

Improvement Permit by: [signature] date 3/31/95

Existing System Inspection by: ____ date ____

Installed by: Rowan Septic Tank

Certificate of Completion by: ____ date ____

Operation Permit by: Wesley Sparks R.S. date 10/26/95

HEALTH DEPT. COPY: WHITE INSPECTION COPY (FINAL): GREEN OWNER COPY (FINAL): YELLOW INSPECTION COPY (INITIAL): PINK OWNER COPY (INITIAL): GOLD