IREDELL COUNTY HEALTH DEPARTMENT

STATESVILLE 704-878-5305 MOORESVILLE 704-664-5281

IMPROVEMENT PERMIT / CERTIFICATE OF COMPLETION / OPERATION PERMIT / EXISTING SYSTEM INSPECTION

PROPERTY DESCRIPTION NO. 20137 DATE March 31, '95 TAX MAP NO. part of 2SA51

OWNER OR CONTRACTOR Krom Financial Services PHONE: Business Home Watershed: ☑ Yes ☐ No WSIV

ADDRESS 19 Yacht Cove Rd, Mooresville 4638-98-6139

LOCATION Faith Rd TR Colnebus Rd - TL Mills Pond Rd 6th lot on left

SUBDIVISION Mills Forest West BLOCK / SECTION LOT 22 LOT AREA .75 Ac SITE CLASS. PS on 1456 DESIGN FLOW 360 gpd L.T.A.R. .3

Septic Tank: 1000 Poly Gallons; STB $325 Date 10/5/95

Pump Tank: Gallons; PT Date

Pump Make: Model Serial No.

Nitrification Field: No Fields 1 Square Feet 1200 Linear Feet 400

No Lines 5 Trench Width 36" Max Trench Bottom Depth 36"

☑ New System ☐ Repair System Type: I, ☐ II, III, IV, V, VI

System Description: gravity conventional

Repair System Description: pumped infiltration

Maintenance Agreement Required: ☐ Yes ☑ No

Gravel Depth 12"

☑ House/Mod. Home No. Bedrooms 3

☐ Mobile Home No. Bathrooms 2

☐ Business No. Employees

☐ Other


☐ Slab ☑ Crawl Space ☐ Basement w/plumbing ☐ Basement wo/plumbing

Water Supply: ☑ Individual ☐ Community ☐ Public

Comments:

Comments: ~~APPROVED~~ ~~SEPTIC TANK~~ ~~PERMIT~~ Ready to Issue

INITIAL SITE SKETCH

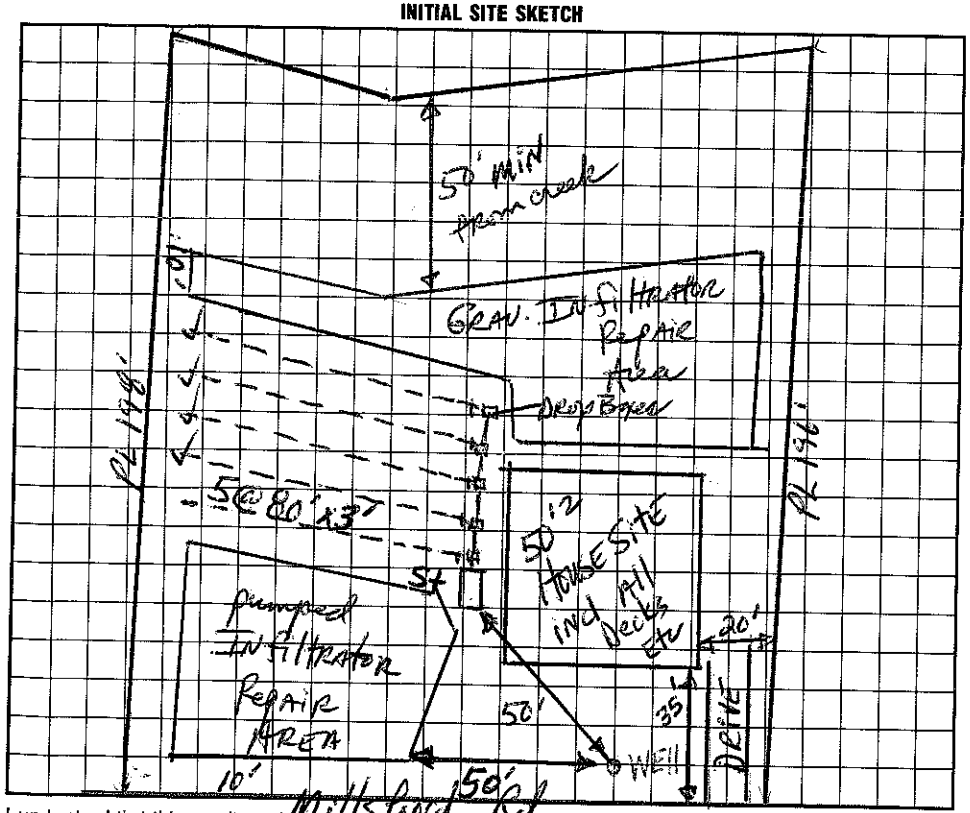

AS BUILT SKETCH

I understand that this permit can be suspended or revoked if any false information is supplied toward securing the permit/any unauthorized changes are made to the site/any unauthorized changes are made in the installation of the system. Improvement Permit is valid for 60 months from date of issuance.

Signed:

Improvement Permit by: Jane R. Hanson, RS Wesley Sparks RS 7/17/95 date 3/31/95

Existing System Inspection by: date

Installed by: Rowan Septic Tank

Certificate of Completion by: Wesley Sparks RS date 11/21/95

Operation Permit by: Wesley Sparks RS date 11/28/95

HEALTH DEPT. COPY: WHITE INSPECTION COPY (FINAL): GREEN OWNER COPY (FINAL): YELLOW INSPECTION COPY (INITIAL): PINK OWNER COPY (INITIAL): GOLD