IREDELL COUNTY HEALTH DEPARTMENT

STATESVILLE 704-878-5305 MOORESVILLE 704-664-5281

IMPROVEMENT PERMIT / CERTIFICATE OF COMPLETION / OPERATION PERMIT / EXISTING SYSTEM INSPECTION

PROPERTY DESCRIPTION NO. 22183 DATE Dec 12, '95 TAX MAP NO. part of 25A51 4638987739 Watershed: ☑ Yes ☐ No

OWNER OR CONTRACTOR Krom Financial Services PHONE: Business _____ Home _____ WS4CA

ADDRESS 149 Yacht Cove Rd. Mooresville

LOCATION Cornelius Rd Turn on Creekview on left just past McKee Ct.

SUBDIVISION Mills Pond BLOCK / SECTION 2 LOT 54 LOT AREA ± 20,000 ft² SITE CLASS PS DESIGN FLOW 360 gpd L.T.A.R. .3

Septic Tank: 1000 Gallons; STB _____ Date _____

Pump Tank: 1000 Gallons; PT _____ Date _____

Pump Make: _____ Model _____ Serial No. _____

Nitrification Field: No Fields 1 Square Feet 1200 Linear Feet 400

No Lines 4@100' Trench Width 36" Max Trench Bottom Depth 36" Gravel Depth 12"

☑ New System ☐ Repair System Type: I, II, (III) IV, V, VI

System Description: pumped pw conventional

Repair System Description: same

Maintenance Agreement Required: ☐ Yes ☑ No

☑ House/Mod. Home No. Bedrooms 3

☐ Mobile Home No. Bathrooms 2

☐ Business No. Employees _____

☐ Other _____

☐ Slab ☑ Crawl Space ☐ Basement w/plumbing ☐ Basement wo/plumbing


Water Supply: ☑ Individual ☐ Community ☐ Public

Comments:


Comments:

1"=50'

INITIAL SITE SKETCH

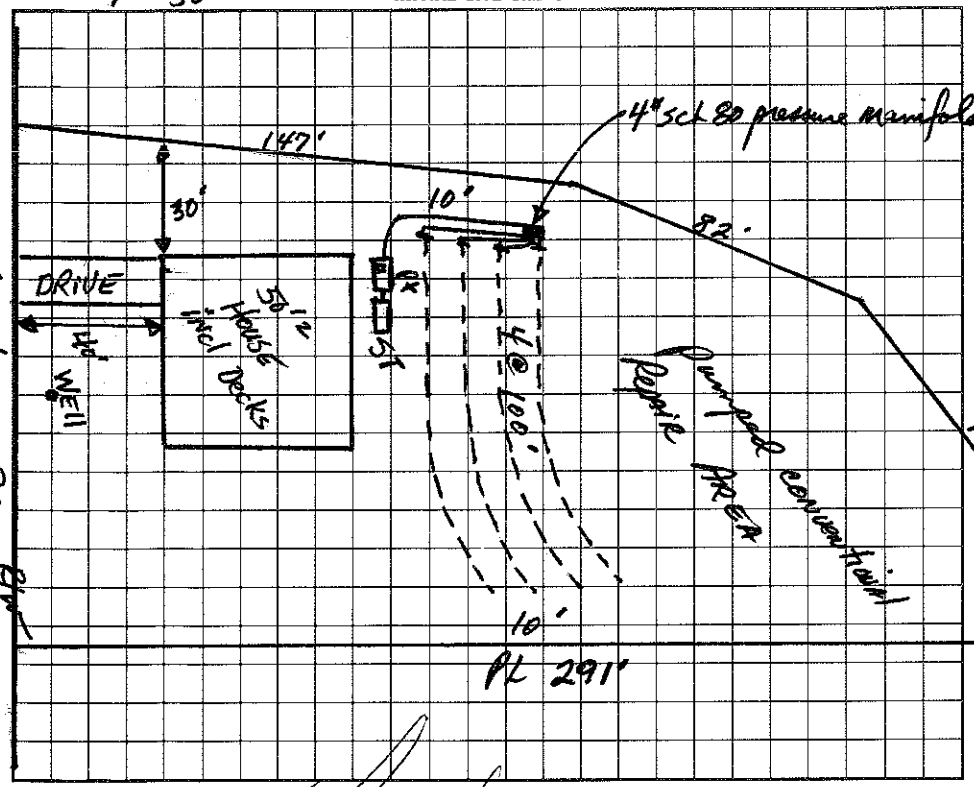

AS BUILT SKETCH

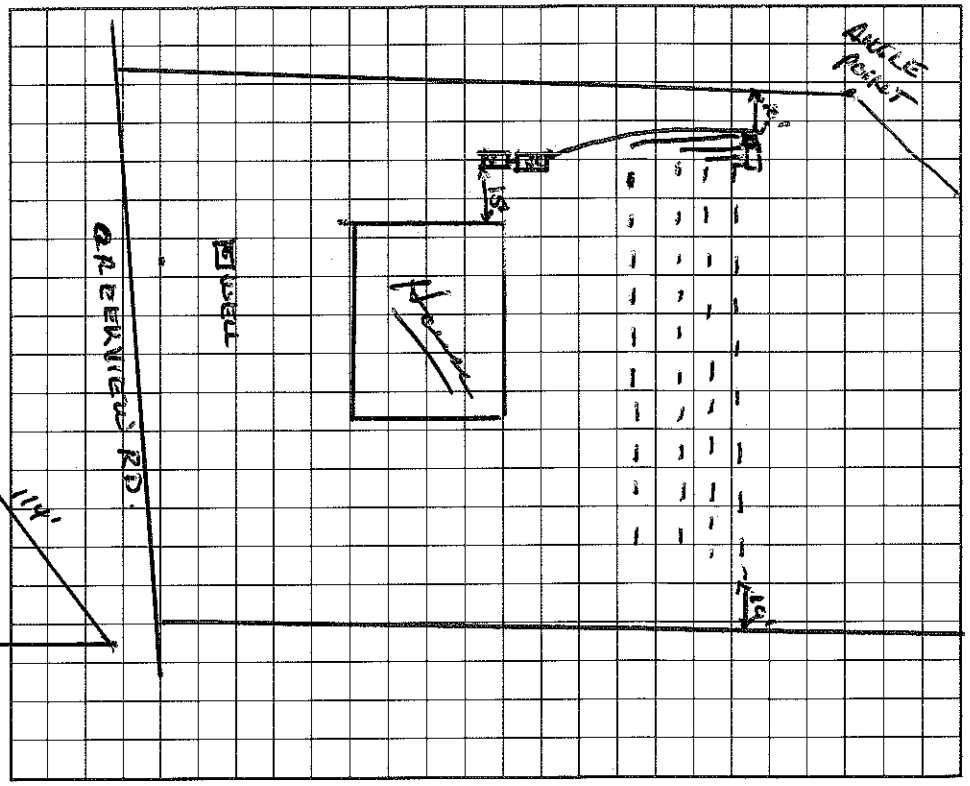

I understand that this permit can be suspended or revoked if any false information is supplied toward securing the permit/any unauthorized changes are made to the site/any unauthorized changes are made in the installation of the system.

Signed: _____

Improvement Permit by: David R. Johnson, RS date 12-12-95

Inspection by: D. R. Johnson, RS date Jan 11 '96

Installed by: Rowan Septic Tank

Certificate of Completion by: _____ date _____

Operation Permit by: C. Ronald Gann date 10/25/96

APPL. COPY: WHITE INSPECTION COPY (FINAL): GREEN OWNER COPY (FINAL): YELLOW INSPECTION COPY (INITIAL): PINK OWNER COPY (INITIAL): GOLD