3:30

IREDELL COUNTY HEALTH DEPARTMENT

STATESVILLE 704-878-5305 MOORESVILLE 704-664-5281

IMPROVEMENT PERMIT / CERTIFICATE OF COMPLETION / OPERATION PERMIT / EXISTING SYSTEM INSPECTI

PROPERTY DESCRIPTION NO. 22173 DATE Feb. 8, '96 TAX MAP NO. part of 25A51 Watershed: ☐ Yes ☐ No

OWNER OR CONTRACTOR Kuon Financial Services PHONE: Business Home 463B-98-8347

ADDRESS 149 Yacht Cove Rd., Mooresville

LOCATION Connecting Rd. Turn on Creekview on Right @ cul-d-sac

SUBDIVISION Mills Pond BLOCK / SECTION LOT 44 LOT AREA .6 Ac. SITE CLASS PS per 1956 DESIGN FLOW 360 gpd L.T.A.R. .3

Septic Tank: 1000 Gallons; STB 875 Date 4-21-96

Pump Tank: Gallons; PT Date

Pump Make: Model Serial No.

Nitrification Field: No Fields 1 Square Feet 1200 Linear Feet 400

No Lines 4@100' Trench Width 36" Max Trench Bottom Depth ±24" Gravel Depth 12"

☑ New System ☐ Repair System Type: I, II, III, IV, V, VI

System Description: gravity conventional grdr. - Infiltrator

Repair System Description:

Maintenance Agreement Required: ☐ Yes ☒ No

☑ House/Mod. Home No. Bedrooms 3

☐ Mobile Home No. Bathrooms 2

☐ Business No. Employees

☐ Other

☑ Slab ☐ Crawl Space ☐ Basement w/plumbing ☐ Basement wo/plumbing


Water Supply: ☑ Individual ☐ Community ☐ Public

Comments:

Comments:

1" = 50'

INITIAL SITE SKETCH

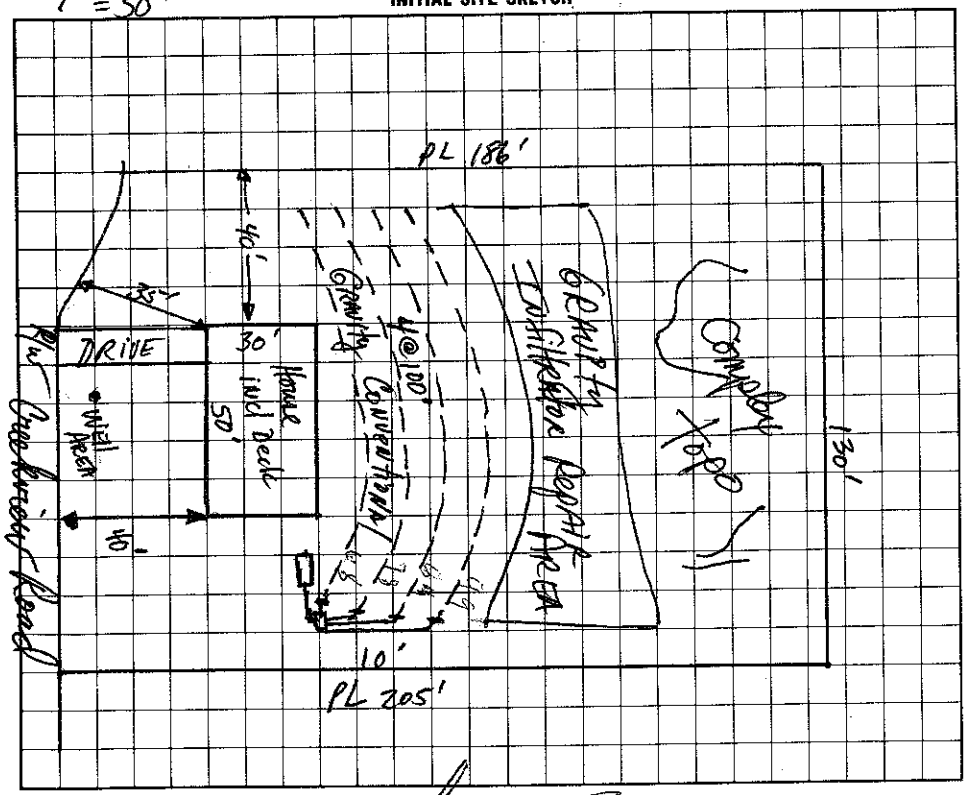

AS BUILT SKETCH

I understand that this permit can be suspended or revoked if any false information is supplied toward securing the permit/any unauthorized changes are made to the site/any unauthorized changes are made in the installation of the system.

Signed:

Improvement Permit by: Patricia R. Hanson, RS date 2-8-96

Existing System Inspection by: Patricia R. Hanson, RS date 2-8-96

Installed by: Rowan Septic

Certificate of Completion by: date

Operation Permit by: C. Bobby Keaton EHSR date 7/9/96

HEALTH DEPT. COPY: WHITE INSPECTION COPY (FINAL): GREEN OWNER COPY (FINAL): YELLOW INSPECTION COPY (INITIAL): PINK OWNER COPY (INITIAL): GOLD