IREDELL COUNTY HEALTH DEPARTMENT

STATESVILLE 704-878-5305 MOORESVILLE 704-664-5281

IMPROVEMENT PERMIT / CERTIFICATE OF COMPLETION / OPERATION PERMIT / EXISTING SYSTEM INSPECTION

PROPERTY DESCRIPTION NO. 22182 DATE Dec 20, '95 TAX MAP NO. part of 25A51 4638 98 8756 Watershed: ☑ Yes ☐ No

OWNER OR CONTRACTOR Krom Financial Services PHONE: Business _____ Home _____ WS4CA

ADDRESS 149 Yacht Cove Rd. Mooresville

LOCATION Cornelius Rd. Turn on Creekview on left past Mikron Ct.

SUBDIVISION Mills Pond BLOCK / SECTION 2 LOT 53 LOT AREA ≥ 30,000 sf± SITE CLASS. PS DESIGN FLOW 360gpd L.T.A.R. .3

Septic Tank: 1000 Gallons; STB 335 Date 01/11/96

Pump Tank: 1000 Gallons; PT 47 Date 5/23/96

Pump Make: Zoeller Model N132 Serial No. _____

Nitrification Field: No Fields 1 Square Feet 1200 Linear Feet 400

No Lines 5@80' Trench Width 36" Max Trench Bottom Depth 36" Gravel Depth 12"

☑ New System ☐ Repair System Type: I, II, (III) IV, V, VI

System Description: pumped-pa-conventional

Repair System Description: same

Maintenance Agreement Required: ☐ Yes ☑ No

☑ House/Mod. Home No. Bedrooms 3

☐ Mobile Home No. Bathrooms 2

☐ Business No. Employees ____

☐ Other _____

☐ Slab ☑ Crawl Space ☐ Basement w/plumbing ☐ Basement wo/plumbing

Water Supply: ☑ Individual ☐ Community ☐ Public


Comments:

Comments: Lines, Pressure, tanks checked 7/22/96.


Electrical checked on _____.

1"=50'

INITIAL SITE SKETCH

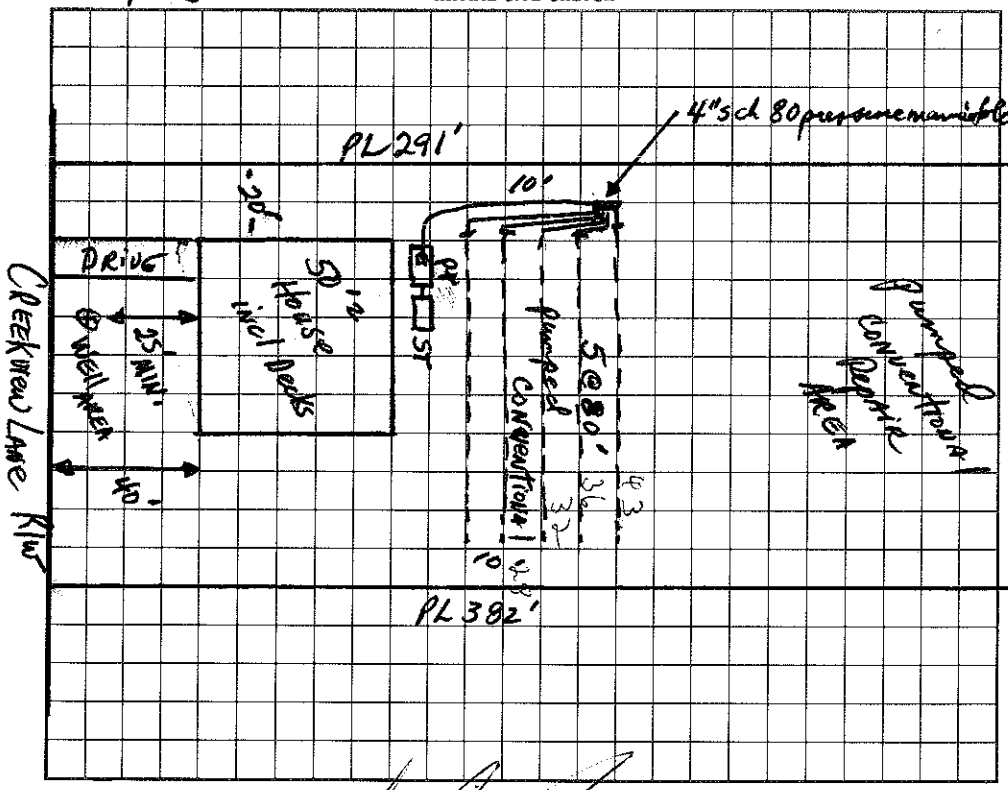

AS BUILT SKETCH

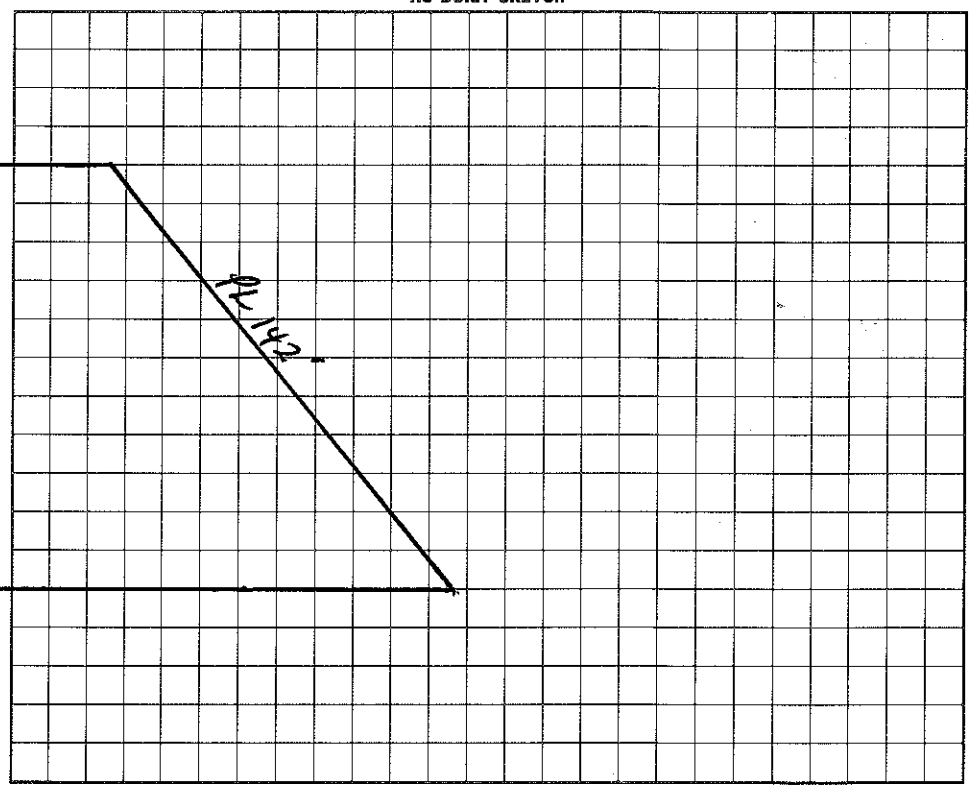

I understand that this permit can be suspended or revoked if any false information is supplied toward securing the permit/any unauthorized changes are made to the site/any unauthorized changes are made in the installation of the system.

Signed: _____

Improvement Permit by: Daniel P. Hunsucker RS date 12-20-95

Existing System Inspection by: _____ RS date Jan 11, '96

Authorization to construct

Installed by: Ronan Septic

Certificate of Completion by: _____ date _____

Operation Permit by: C. Bailey Kelly EHSF date 7/24/96

HEALTH DEPT. COPY: WHITE INSPECTION COPY (FINAL): GREEN OWNER COPY (FINAL): YELLOW INSPECTION COPY (INITIAL): PINK OWNER COPY (INITIAL): GOLD