(4,00)

IREDELL COUNTY HEALTH DEPARTMENT

STATESVILLE 704-878-5305 MOORESVILLE 704-664-5281

IMPROVEMENT PERMIT / AUTHORIZATION TO CONSTRUCT / OPERATION PERMIT / EXISTING SYSTEM INSPECTION

PERMIT# 071731 PIN# 4638 98 9222 DATE 2/23/98

OWNER OR CONTRACTOR TEK Contractors PHONE: Business 788-8676 Home

ADDRESS 298 Union St. S Concord, NC. 28025

LOCATION Cornelius TR Creek View to end on R

SUBDIVISION MILLS POND BLOCK / SECTION 2 LOT 45 LOT AREA .95 SITE CLASS. PS DESIGN FLOW 360 L.T.A.R. .25

Septic Tank: 1000 Gallons; STB 525 Date 3/6/97

Pump Tank: 1000 Gallons; PT 1147 Date 2/11/98

Pump Make: Model Serial No.

Nitrification Field: No Fields 1 Square Feet 1200* Linear Feet 400*

No Lines 4 Trench Width 36" Max Trench Bottom Depth 36" Gravel Depth

☒ New System ☐ Repair System Type: I, II, III, IV, V, VI

System Description: Pres Manifold - Conventional

Repair System Description: Pres Man - LP PANEL

Maintenance Agreement Required: ☐ Yes ☒ No

☒ House/Mod. Home No. Bedrooms 3

☐ Mobile Home No. Bathrooms 2

☐ Business No. Employees

☐ Other

☐ Slab ☒ Crawl Space ☐ Basement w/plumbing ☐ Basement wo/plumbing


Water Supply: ☒ Individual ☐ Public ☐ Community

Comments/Conditions:


Comments:/Conditions:

MANIFOLD FLIPPED TO OTHER SIDE

INITIAL SITE SKETCH

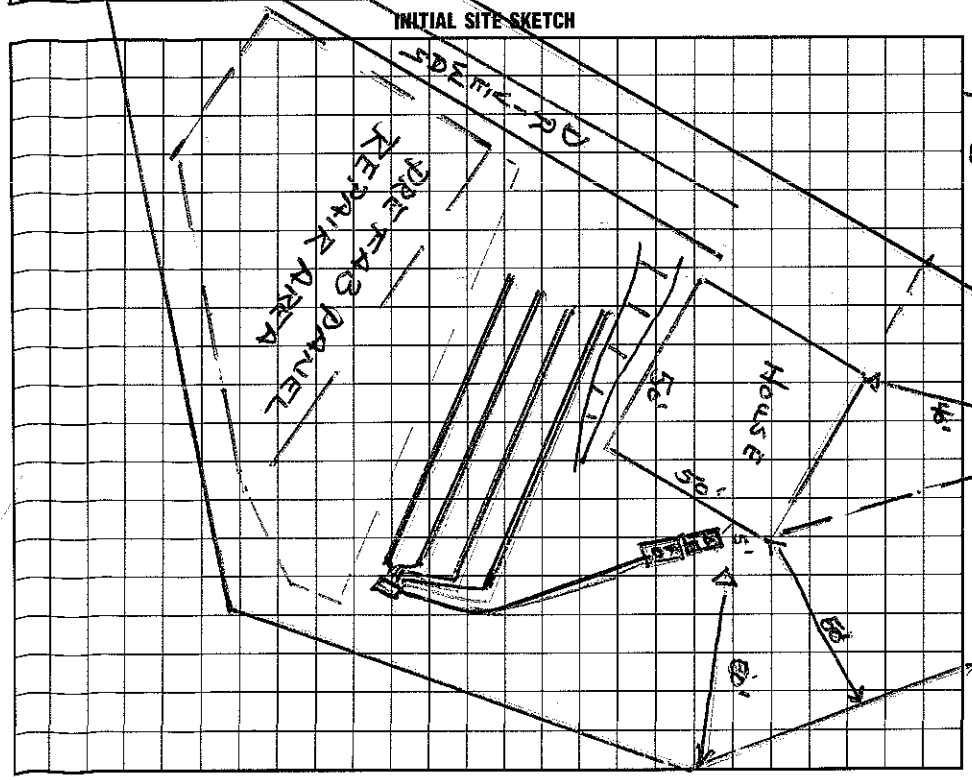

AS BUILT SKETCH

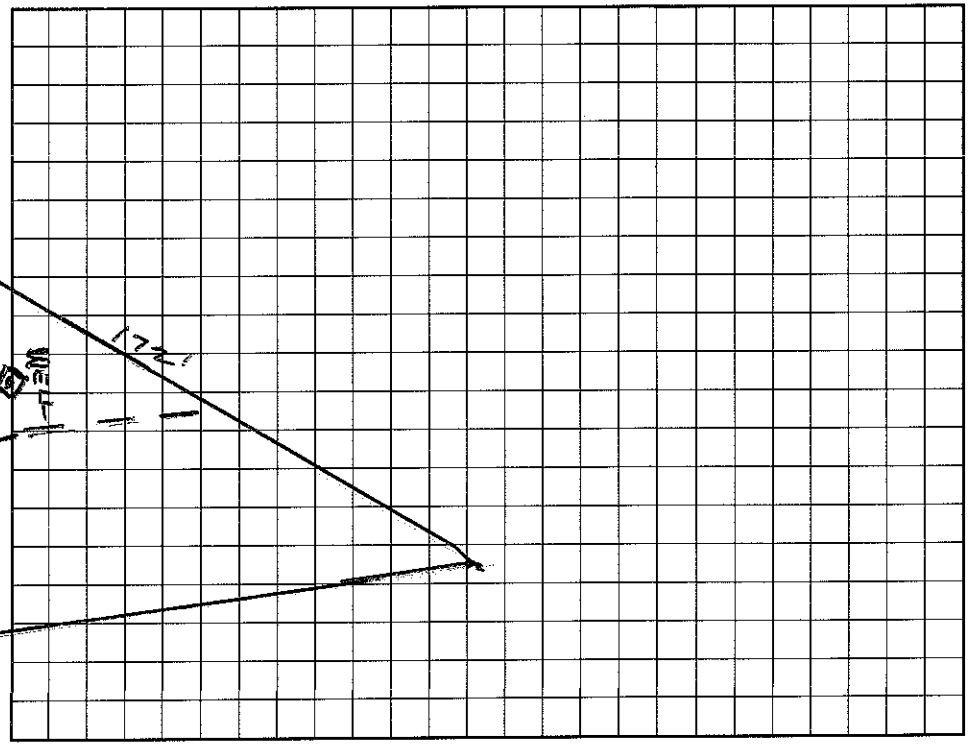

I understand that this permit can be suspended or revoked if any false information is supplied toward securing the permit/any unauthorized changes are made to the site/any unauthorized changes are made in the installation of the system. Improvement Permit with plat valid without expiration. Improvement Permit with site plan valid for sixty months. Authorization to Construct is valid for a period equal to that of Improvement Permit – not to exceed sixty months.

Signed: Daniel P. Mabe date 2/23/98

Improvement Permit by: Wesley Sparks R.S. date 2/23/98

Authorization to Construct by: Wesley Sparks R.S. date 2/23/98

Installed by: ROWAN SEPTIC

Operation Permit by: C. [signature] date 8/18/98

Existing System Inspection by: date

HEALTH DEPT. COPY: WHITE INSPECTION COPY (FINAL): GREEN OWNER COPY (FINAL): YELLOW INSPECTION COPY (INITIAL): PINK OWNER COPY (INITIAL): GOLD