IREDELL COUNTY HEALTH DEPARTMENT

STATESVILLE 704-878-5305 MOORESVILLE 704-664-528

IMPROVEMENT PERMIT / CERTIFICATE OF COMPLETION / OPERATION PERMIT / EXISTING SYSTEM INSPE

PROPERTY DESCRIPTION NO. 22181 DATE Dec 20, '95 TAX MAP NO. part of 2SA51 4638 98 9638 Watershed: ☑ Yes ☐ No

OWNER OR CONTRACTOR Kapp Financial Services PHONE: Business Home LW54CA

ADDRESS 149 Yacht Cove Rd. / Mooresville

LOCATION Coopers Rd. Farm on Creekview on left past Mckeon Ct.

SUBDIVISION Mills Pond BLOCK / SECTION 2 LOT 52 LOT AREA ± 25,000 ft² SITE CLASS. PS DESIGN FLOW 360 gpd L.T.A.R. 1.3

Septic Tank: 1000 Gallons; STB 825 Date 10/20/95

Pump Tank: 1000 Gallons; PT 49 Date 10/2/96

Pump Make: ZOELLER Model N137 Serial No.

Nitrification Field: No Fields ___ Square Feet 1200 Linear Feet 400

No Lines 4@100' Trench Width 36" Max Trench Bottom Depth 36" Gravel Depth 12"

☑ New System ☐ Repair System Type: I, II, ☐ IV, V, VI

System Description: pumped-pw-conventional

Repair System Description: same

Maintenance Agreement Required: ☐ Yes ☑ No

☑ House/Mod. Home No. Bedrooms 3

☐ Mobile Home No. Bathrooms 2

☐ Business No. Employees ___

☐ Other


☐ Slab ☑ Crawl Space ☐ Basement w/plumbing ☐ Basement wo/plumbing

Water Supply: ☑ Individual ☐ Community ☐ Public


Comments:

Comments:

INITIAL SITE SKETCH

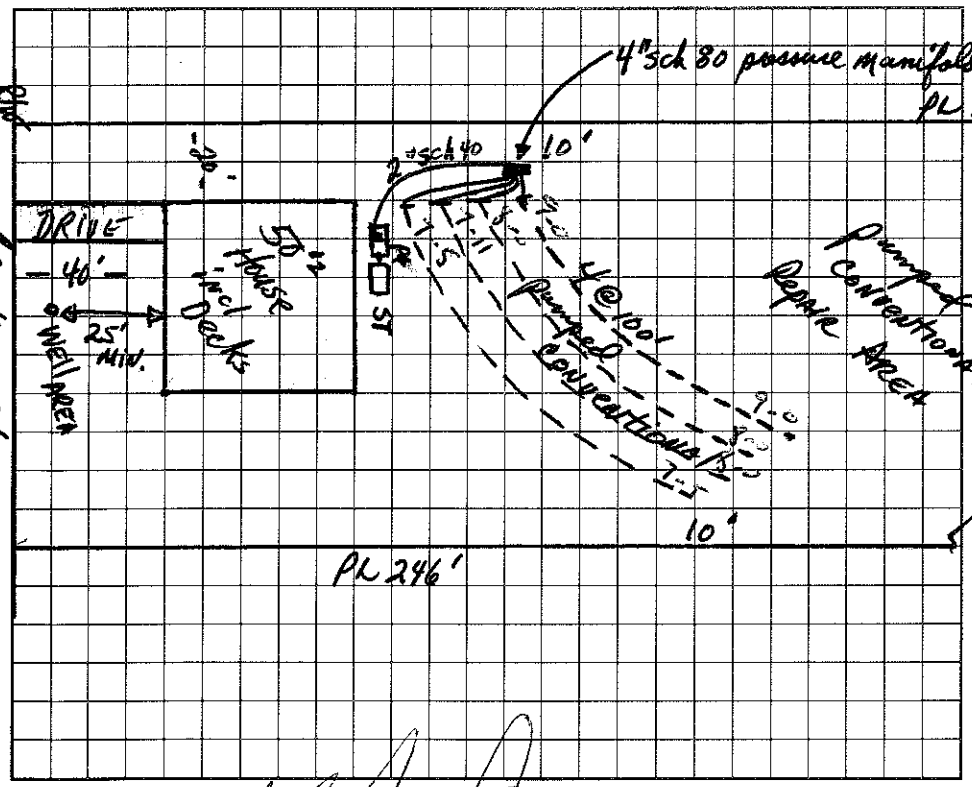

AS BUILT SKETCH

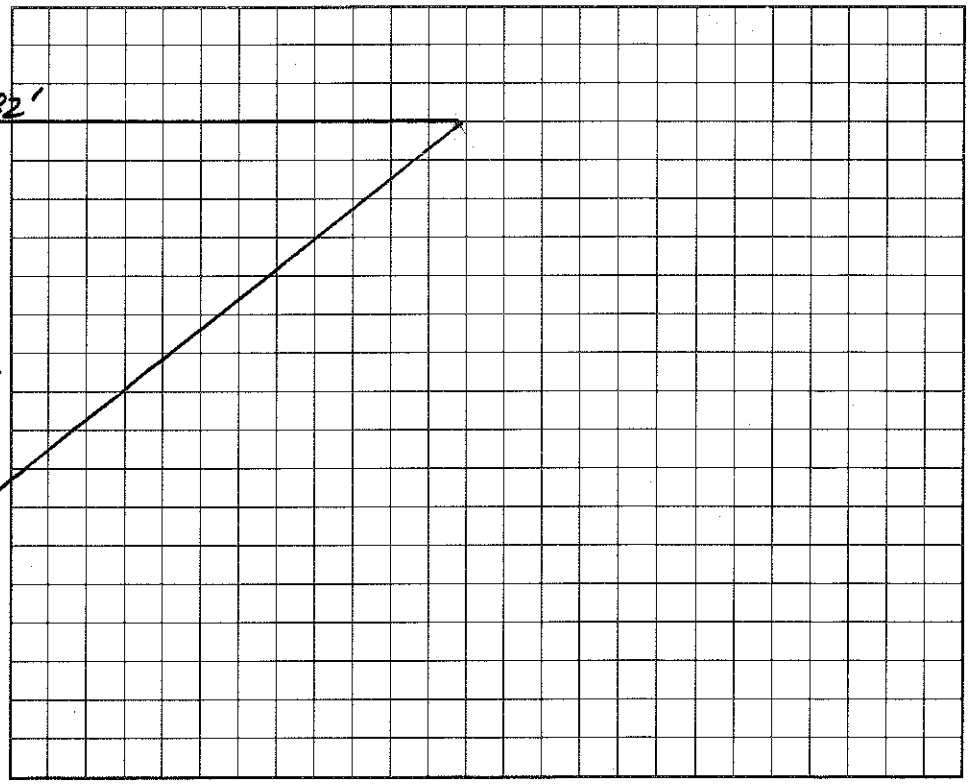

I understand that this permit can be suspended or revoked if any false information is supplied toward securing the permit/any unauthorized changes are made to the site/any unauthorized changes are made in the installation of the system.

Signed: X

Improvement Permit by: Darrell R Johnson, RS date 12-20-95

Existing System Inspection by: D R Johnson, RS date Jan 11, '96

Authorization to construct

Installed by: Rowan Septic Tank

Certificate of Completion by: ___ date ___

Operation Permit by: Wesley Sparks RS. date 1/22/97

HEALTH DEPT. COPY: WHITE INSPECTION COPY (FINAL): GREEN OWNER COPY (FINAL): YELLOW INSPECTION COPY (INITIAL): PINK OWNER COPY (INITIAL): GOLD