IREDELL COUNTY HEALTH DEPARTMENT

STATESVILLE 704-878-5305 MOORESVILLE 704-664-5281

IMPROVEMENT PERMIT / CERTIFICATE OF COMPLETION / OPERATION PERMIT / EXISTING SYSTEM INSPECTION

PROPERTY DESCRIPTION NO. 20544 DATE April 23, '95 TAX MAP NO. part of 25A51 Watershed: ☒ Yes ☐ No

OWNER OR CONTRACTOR Krom Financial Services PHONE: Business _____ Home _____ WS IV

ADDRESS 19 Yacht Cove Rd, Mooresville 4638-99-1599

LOCATION Perth Rd. N. TR Cornelius Rd. TL Creek View Lane TR Windrock Lane 2nd lot on left

SUBDIVISION Mills Pond BLOCK / SECTION _____ LOT 76 LOT AREA .69Ac SITE CLASS. PS per 1988 DESIGN FLOW 360gpd L.T.A.R. .3

Septic Tank: 1600 Gallons; STB 825 Date 6/26/96

Pump Tank: _____ Gallons; PT _____ Date _____

Pump Make: _____ Model _____ Serial No. _____

Nitrification Field: No Fields 1 Square Feet 900 Linear Feet 300

No Lines 3 Trench Width 36" Max Trench Bottom Depth 36" Gravel Depth N/A

☒ New System ☐ Repair System Type: I, II, (III), IV, V, VI

System Description: Quartz Infiltrator

Repair System Description: gravity/pumped Inf/conv.

Maintenance Agreement Required: ☐ Yes ☐ No

☒ House/Mod. Home No. Bedrooms 3

☐ Mobile Home No. Bathrooms 2

☐ Business No. Employees _____

☐ Other _____

☐ Slab ☐ Crawl Space ☐ Basement w/plumbing ☐ Basement wo/plumbing


Water Supply: ☒ Individual ☐ Community ☐ Public

Comments:

Comments: DE[redacted] APPROVED PE[redacted] 9/23/95

1" = 50'

INITIAL SITE SKETCH

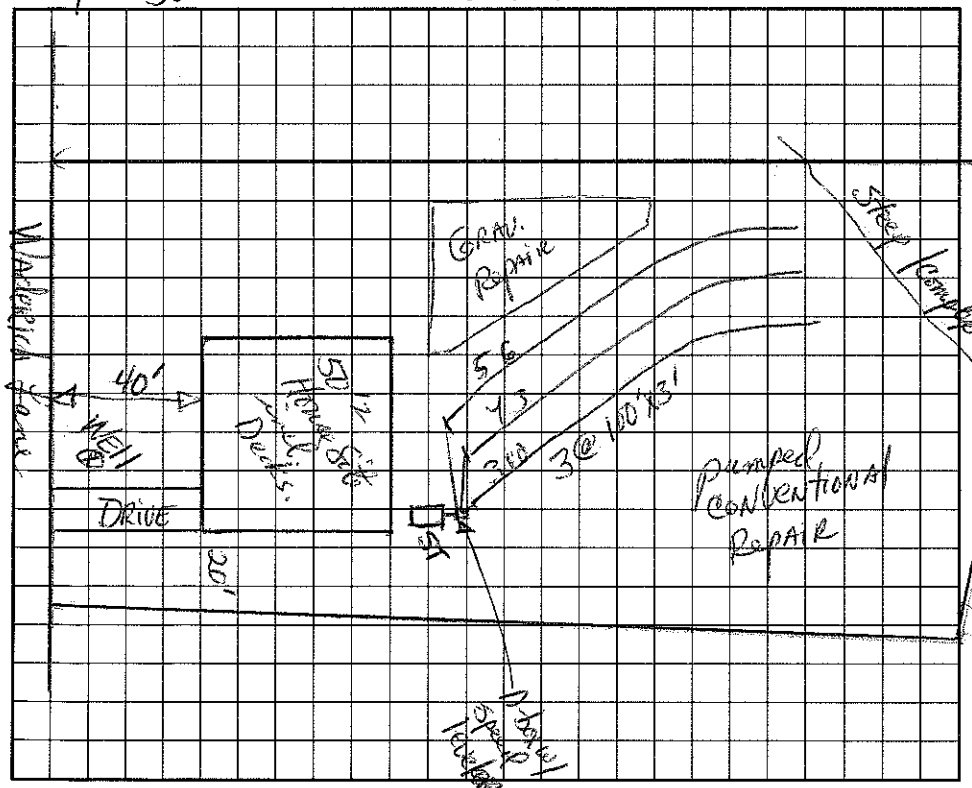

AS BUILT SKETCH

I understand that this permit can be suspended or revoked if any false information is supplied toward securing the permit/any unauthorized changes are made to the site/any unauthorized changes are made in the installation of the system. Improvement Permit is valid for 60 months from date of issuance.

Signed: X _____ Wesley Sparks R.S. 9/23/95

Improvement Permit by: Howard R. Jones, RS date 4/23/95

Existing System Inspection by: _____ date _____

Installed by: ROWAN SEPTIC

Certificate of Completion by: _____ date _____

Operation Permit by: C. Bailey Jones EHSI date 7/29/96

HEALTH DEPT. COPY: WHITE INSPECTION COPY (FINAL): GREEN OWNER COPY (FINAL): YELLOW INSPECTION COPY (INITIAL): PINK OWNER COPY (INITIAL): GOLD