IREDELL COUNTY HEALTH DEPARTMENT

STATESVILLE 704-878-5305 MOORESVILLE 704-664-5281

IMPROVEMENT PERMIT / CERTIFICATE OF COMPLETION / OPERATION PERMIT / EXISTING SYSTEM INSPECTION

PROPERTY DESCRIPTION NO. 20548 DATE April 23, '95 TAX MAP NO. part of 2545/ Watershed: ☑ Yes ☐ No

OWNER OR CONTRACTOR Kyon Financial Services PHONE: Business / Home / WSIV

ADDRESS 19 Jacht Cove Rd., Mooresville 4638-99-82-75

LOCATION Perth Rd. N. TR Cornelius Rd. TL Creek View Lane TL Walbrick Lane 1st lot on right (corner lot)

SUBDIVISION Mills Pond BLOCK / SECTION / LOT 66 LOT AREA ± .73Ac SITE CLASS. PS pre 1956 DESIGN FLOW 360gpd L.T.A.R. .03

Septic Tank: 1000 Gallons; STB 825 Date 12/21/96

Pump Tank: / Gallons; PT / Date /

Pump Make: / Model / Serial No. /

Nitrification Field: No Fields 1 Square Feet 700 Linear Feet 300

No Lines 2 Trench Width 36" Max Trench Bottom Depth 36" Gravel Depth NA

☑ New System ☐ Repair System Type: I, II, III, IV, V, VI

System Description: gravity Infiltrator

Repair System Description: Scarify or grow PPBPS

Maintenance Agreement Required: ☐ Yes ☑ No

☑ House/Mod. Home No. Bedrooms 3

☐ Mobile Home No. Bathrooms 2

☐ Business No. Employees /

☐ Other /


☑ Slab ☐ Crawl Space ☐ Basement w/plumbing ☐ Basement wo/plumbing

Water Supply: ☑ Individual ☐ Community ☐ Public


Comments: 43
49
510

Comments: [redacted] PERMIT

INITIAL SITE SKETCH

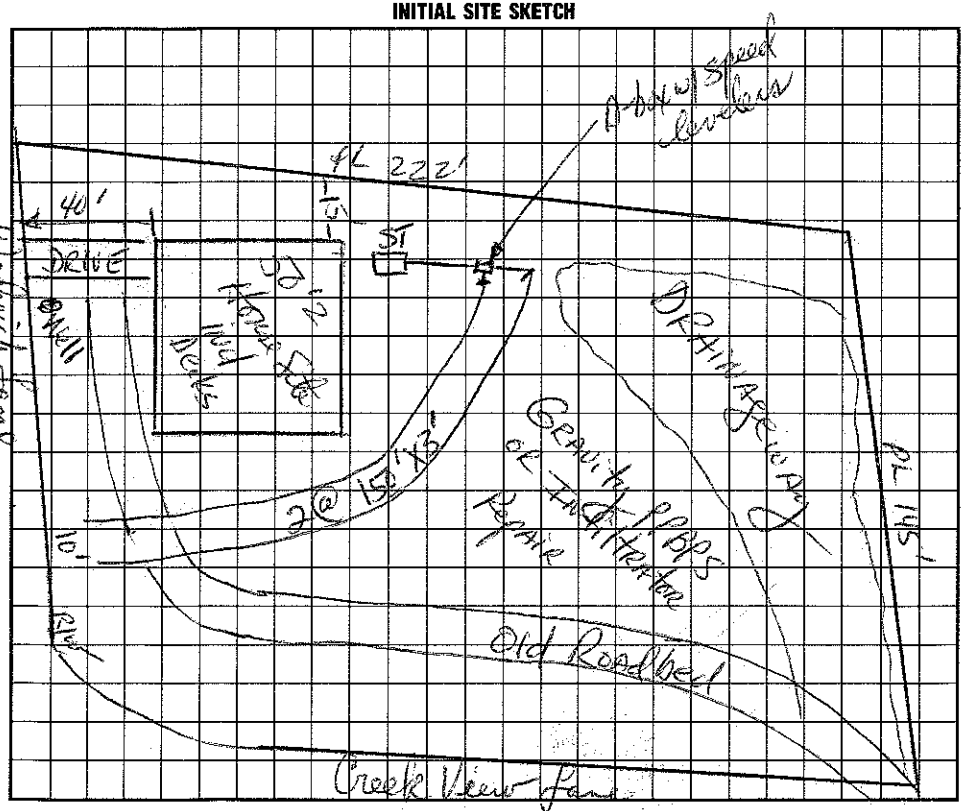

AS BUILT SKETCH

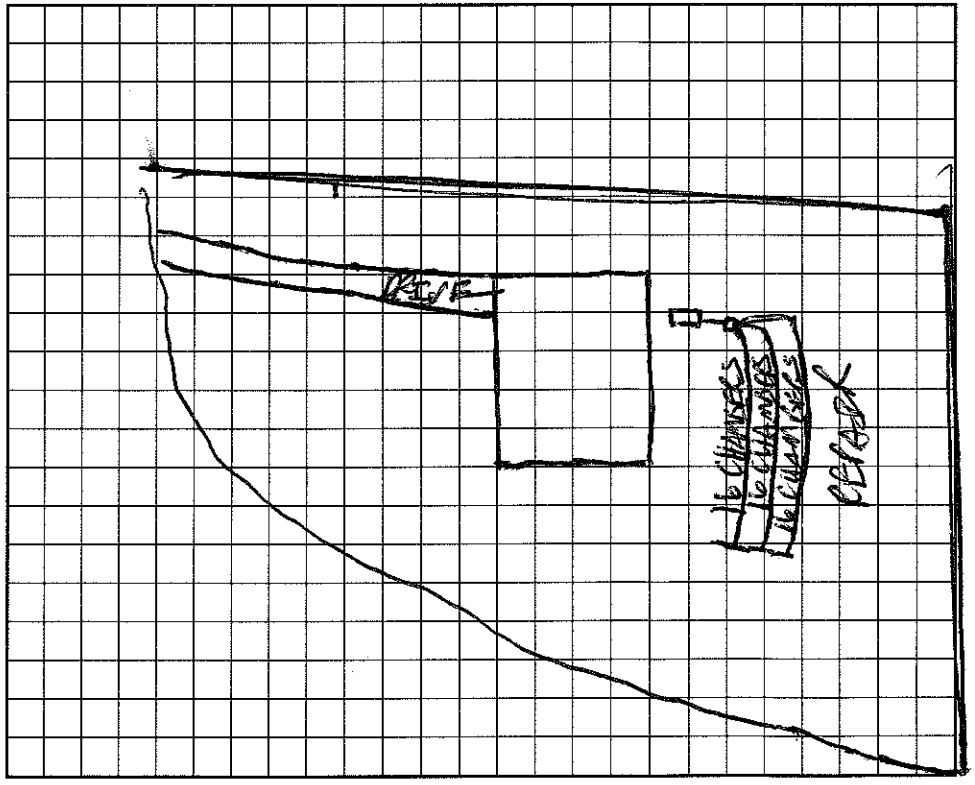

I understand that this permit can be suspended or revoked if any false information is supplied toward securing the permit/any unauthorized changes are made to the site/any unauthorized changes are made in the installation of the system. Improvement Permit is valid for 60 months from date of issuance.

Signed: [signature]

Improvement Permit by: [signature], RS Westlake Specialist date 4/23/95

Existing System Inspection by: / date /

Installed by: ROWAN SEPTIC

Certificate of Completion by: / date /

Operation Permit by: [signature] EHSI date 2/20/97

HEALTH DEPT. COPY: WHITE INSPECTION COPY (FINAL): GREEN OWNER COPY (FINAL): YELLOW INSPECTION COPY (INITIAL): PINK OWNER COPY (INITIAL): GOLD