IREDELL COUNTY HEALTH DEPARTMENT

STATESVILLE 704-878-5305 MOORESVILLE 704-664-5281

IMPROVEMENT PERMIT / CERTIFICATE OF COMPLETION / OPERATION PERMIT / EXISTING SYSTEM INSPECTION

PROPERTY DESCRIPTION NO. 20545 DATE April 23, '95 TAX MAP NO. part of 2SA51 Watershed: ☑ Yes ☐ No

OWNER OR CONTRACTOR Kron Financial Services PHONE: Business _____ Home _____

ADDRESS 19 Yacht Cove Rd Mooresville 4638-99-2695

LOCATION Poth Rd N. TR Cornelius Rd TL Creek View Lane TL Warbrick Lane 3rd lot on left

SUBDIVISION Mills Pond BLOCK / SECTION _____ LOT 75 LOT AREA 1.65 AC SITE CLASS. PSpm 1956 DESIGN FLOW 360 gpd L.T.A.R. .3

Septic Tank: 1000 Gallons; STB 325 Date 12/11/95

Pump Tank: _____ Gallons; PT _____ Date _____

Pump Make: _____ Model _____ Serial No. _____

Nitrification Field: No Fields 1 Square Feet 900 Linear Feet 300

No Lines 3 Trench Width 36" Max Trench Bottom Depth 36" Gravel Depth N/A

☑ New System ☐ Repair System Type: I, II, III, IV, V, VI

System Description: gravity Infiltrator

Repair System Description: pumped conventional

Maintenance Agreement Required: ☐ Yes ☑ No

☐ House/Mod. Home No. Bedrooms 3

☐ Mobile Home No. Bathrooms 2

☐ Business No. Employees ____

☐ Other _____

☐ Slab ☑ Crawl Space ☐ Basement w/plumbing ☐ Basement wo/plumbing


Water Supply: ☑ Individual ☐ Community ☐ Public

Comments:

Comments: DEVELOPER PERMIT 9/23/95 AWS

1" = 50'

INITIAL SITE SKETCH

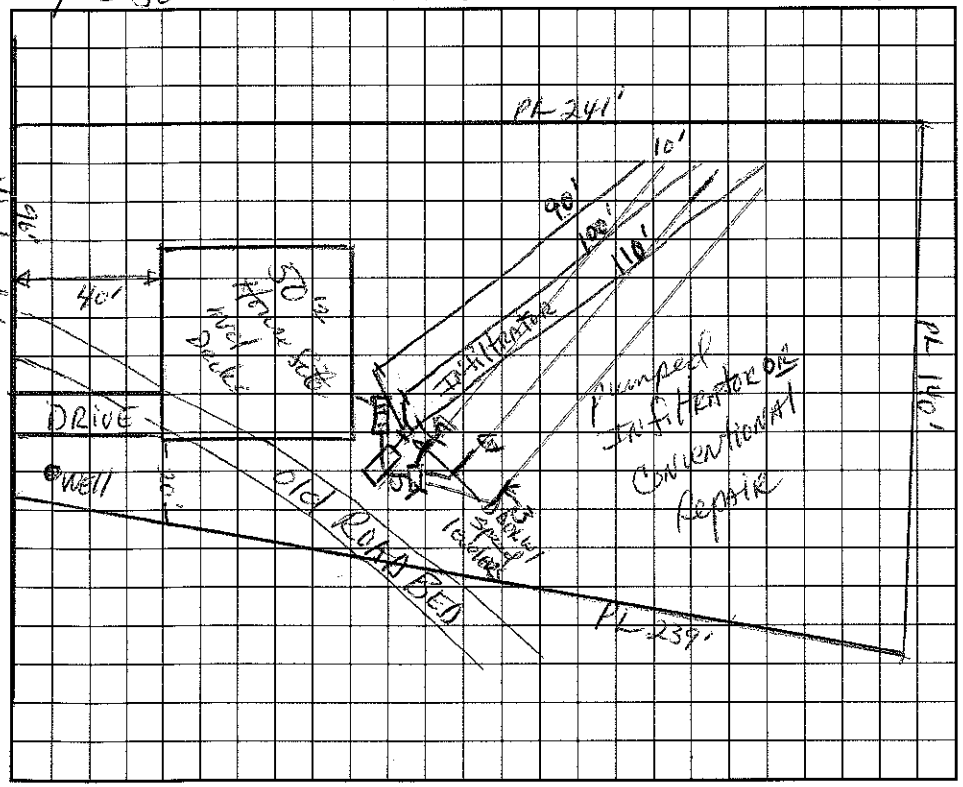

AS BUILT SKETCH

I understand that this permit can be suspended or revoked if any false information is supplied toward securing the permit/any unauthorized changes are made to the site/any unauthorized changes are made in the installation of the system. Improvement Permit is valid for 60 months from date of issuance.

Signed: _____ Wesley Sparks RS 9/23/95

Improvement Permit by: Jack Hamm RS date 4/23/95

Existing System Inspection by: _____ date _____

Installed by: Rowan Septic Tank

Certificate of Completion by: _____ date _____

Operation Permit by: Wesley Sparks RS. date 3/12/96

HEALTH DEPT. COPY: WHITE INSPECTION COPY (FINAL): GREEN OWNER COPY (FINAL): YELLOW INSPECTION COPY (INITIAL): PINK OWNER COPY (INITIAL): GOLD