IREDELL COUNTY HEALTH DEPARTMENT

STATESVILLE 704-878-5305 MOORESVILLE 704-664-5281

IMPROVEMENT PERMIT / CERTIFICATE OF COMPLETION / OPERATION PERMIT / EXISTING SYSTEM INSPECTION

PROPERTY DESCRIPTION NO. 22204 DATE Feb. 6, '96 TAX MAP NO. part of 2SA51 Watershed: ☑ Yes ☐ No

OWNER OR CONTRACTOR Krom Financial Services PHONE: Business Home 4638-99-2828

ADDRESS 149 Yacht Cove Rd. Mooresville

LOCATION Coonfling Rd. Turn on Creekview Tr Milbros Cv. on Right at cul-de-sac

SUBDIVISION Mills Pond BLOCK / SECTION LOT 81 LOT AREA .51 Ac SITE CLASS PS per 1956 DESIGN FLOW 360gpd L.T.A.R. 3

Septic Tank: 1000 Gallons; STB 825 Date 6/2/96

Pump Tank: Gallons; PT Date

Pump Make: Model Serial No.

Nitrification Field: No Fields 1 Square Feet 1200 Linear Feet 400

No Lines 3-4 Trench Width 36" Max Trench Bottom Depth 36" Gravel Depth 12"

☑ New System ☐ Repair System Type: I II III IV V VI

System Description: gravity conventional

Repair System Description: gravity infiltrator

Maintenance Agreement Required: ☐ Yes ☑ No

☑ House/Mod. Home No. Bedrooms 3

☐ Mobile Home No. Bathrooms 2

☐ Business No. Employees

☐ Other

☑ Slab ☐ Crawl Space ☐ Basement w/plumbing ☐ Basement wo/plumbing


Water Supply: ☑ Individual ☐ Community ☐ Public

Comments:

Comments: 69 76 79 79

1"=50'

INITIAL SITE SKETCH

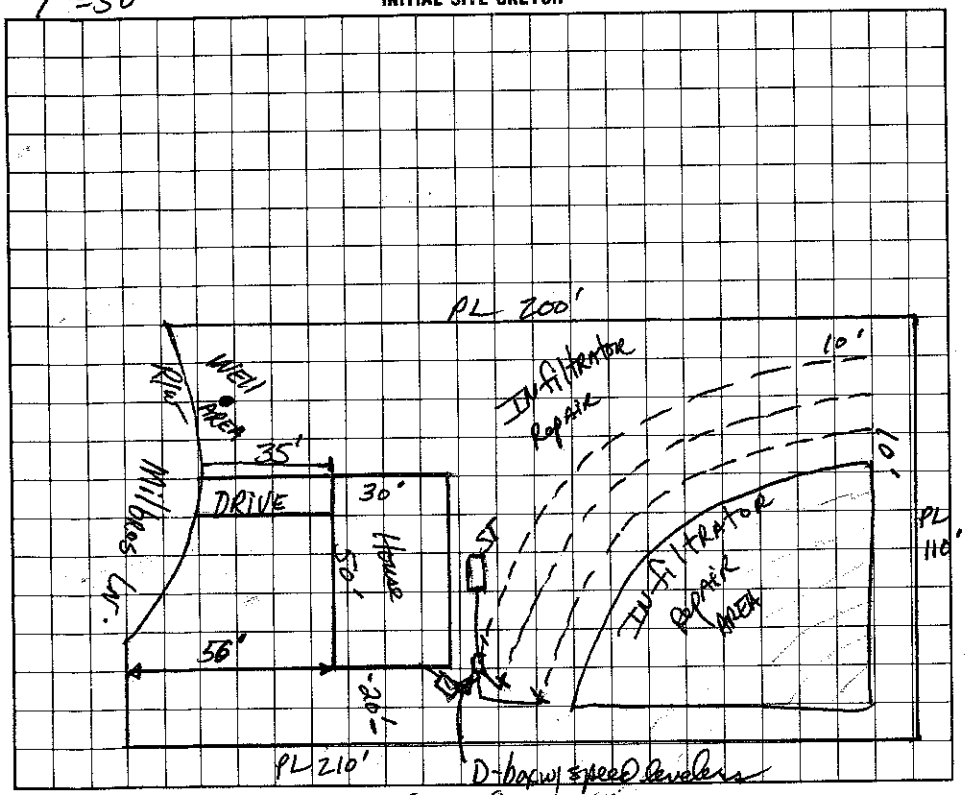

AS BUILT SKETCH

Installed 4 lines instead of 3.

I understand that this permit can be suspended or revoked if any false information is supplied toward securing the permit/any unauthorized changes are made to the site/any unauthorized changes are made in the installation of the system.

Signed:

Improvement Permit by: , RS date 2-6-96

Authorization and System Inspection by: , RS date 2-6-96

Installed by: Rowan Septic

Certificate of Completion by: date

Operation Permit by: date 7/30/96

HEALTH DEPT. COPY: WHITE INSPECTION COPY (FINAL): GREEN OWNER COPY (FINAL): YELLOW INSPECTION COPY (INITIAL): PINK OWNER COPY (INITIAL): GOLD