IREDELL COUNTY HEALTH DEPARTMENT

STATESVILLE 704-878-5305 MOORESVILLE 704-664-5281

IMPROVEMENT PERMIT / CERTIFICATE OF COMPLETION / OPERATION PERMIT / EXISTING SYSTEM INSPECTION

PROPERTY DESCRIPTION NO. 22194 DATE Dec 20, '95 TAX MAP NO. part of 2545 Watershed: ☑ Yes ☐ No

OWNER OR CONTRACTOR Krony Financial Services PHONE: Business Home

ADDRESS 149 Yacht Cove Rd. Mooresville 4638-99-3087 WS4CA

LOCATION Connecting Rd. Turn Creekview Rd. TR McKown Ct on left corner lot

SUBDIVISION Mills Pond BLOCK / SECTION LOT 65 LOT AREA 1.64 Ac SITE CLASS. RS DESIGN FLOW 360 gpd L.T.A.R. .3

Septic Tank: 1000 Gallons; STB 825 Date 2/13/96

Pump Tank: Gallons; PT Date

Pump Make: Model Serial No.

Nitrification Field: No Fields 1 Square Feet 1200 Linear Feet 400

No Lines 4@100 Trench Width 36" Max Trench Bottom Depth 36" Gravel Depth 12"

☑ New System ☐ Repair System Type: I, II, III, IV, V, VI

System Description: gravity conventional

Repair System Description: same

Maintenance Agreement Required: ☐ Yes ☑ No

☑ House/Mod. Home No. Bedrooms 3

☐ Mobile Home No. Bathrooms 2

☐ Business No. Employees

☐ Other

☐ Slab ☑ Crawl Space ☐ Basement w/plumbing ☐ Basement wo/plumbing


Water Supply: ☑ Individual ☐ Community ☐ Public

Comments:

Comments:

1" ≃ 50'

INITIAL SITE SKETCH

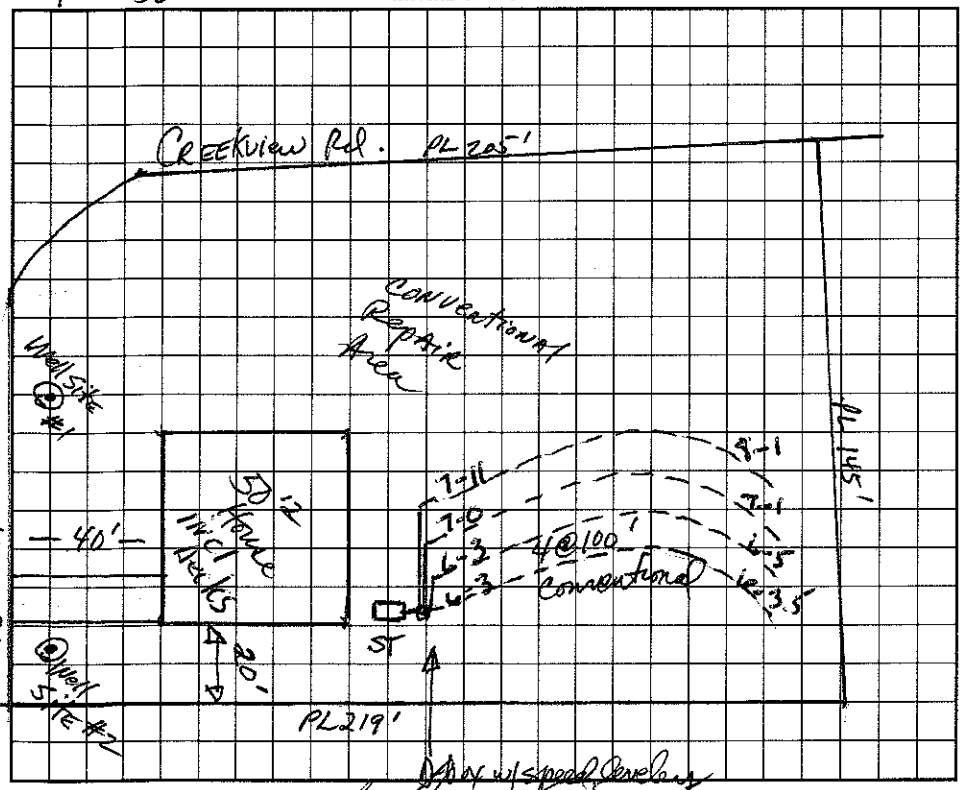

AS BUILT SKETCH

I understand that this permit can be suspended or revoked if any false information is supplied toward securing the permit/any unauthorized changes are made to the site/any unauthorized changes are made in the installation of the system.

Signed: X

Improvement Permit by: D R Swain, RS date 12-20-95

Existing System Inspection by: D R Swain, RS date 12-21-95

Installed by: Rowan Septic Tank

Certificate of Completion by: date

Operation Permit by: Wesley Sparks RS. date 6/6/96

Authorization to construct

WHITE: DEPT. COPY: WHITE INSPECTION COPY (FINAL): GREEN OWNER COPY (FINAL): YELLOW INSPECTION COPY (INITIAL): PINK OWNER COPY (INITIAL): GOLD