IREDELL COUNTY HEALTH DEPARTMENT

STATESVILLE 704-878-5305 MOORESVILLE 704-664-5281

IMPROVEMENT PERMIT / CERTIFICATE OF COMPLETION / OPERATION PERMIT / EXISTING SYSTEM INSPECTION

PROPERTY DESCRIPTION NO. 22205 DATE Dec 18, '95 TAX MAP NO. part of 2SA51 Watershed: ☑ Yes ☐ No WS4CA

OWNER OR CONTRACTOR Kwon Financial Services PHONE: Business Home 4638-99-3962

ADDRESS 149 Yacht Cove Rd., Mooresville

LOCATION Cornelius Rd. Turn Creekview TL Millbros Ln: in cul-d-sac on right

SUBDIVISION Mills Pond BLOCK / SECTION LOT 82 LOT AREA .85 AC SITE CLASS. PS DESIGN FLOW 360 gpd L.T.A.R. .3

Septic Tank: 1000 Gallons; STB 825 Date 5/1/96
Pump Tank: Gallons; PT Date
Pump Make: Model Serial No.
Nitrification Field: No Fields 1 Square Feet 1200 Linear Feet 400
No Lines 4@100' Trench Width 36" Max Trench Bottom Depth 36" Gravel Depth 12"

☑ New System ☐ Repair System Type: I (II) III. IV. V. VI
System Description: gravity conventional
Repair System Description: same
Maintenance Agreement Required: ☐ Yes ☑ No

☑ House/Mod. Home No. Bedrooms 3
☐ Mobile Home No. Bathrooms 2
☐ Business No. Employees
☐ Other

☐ Slab ☑ Crawl Space ☐ Basement w/plumbing ☐ Basement wo/plumbing


Water Supply: ☑ Individual ☐ Community ☐ Public

Comments:

Comments:

1" = 50'

INITIAL SITE SKETCH

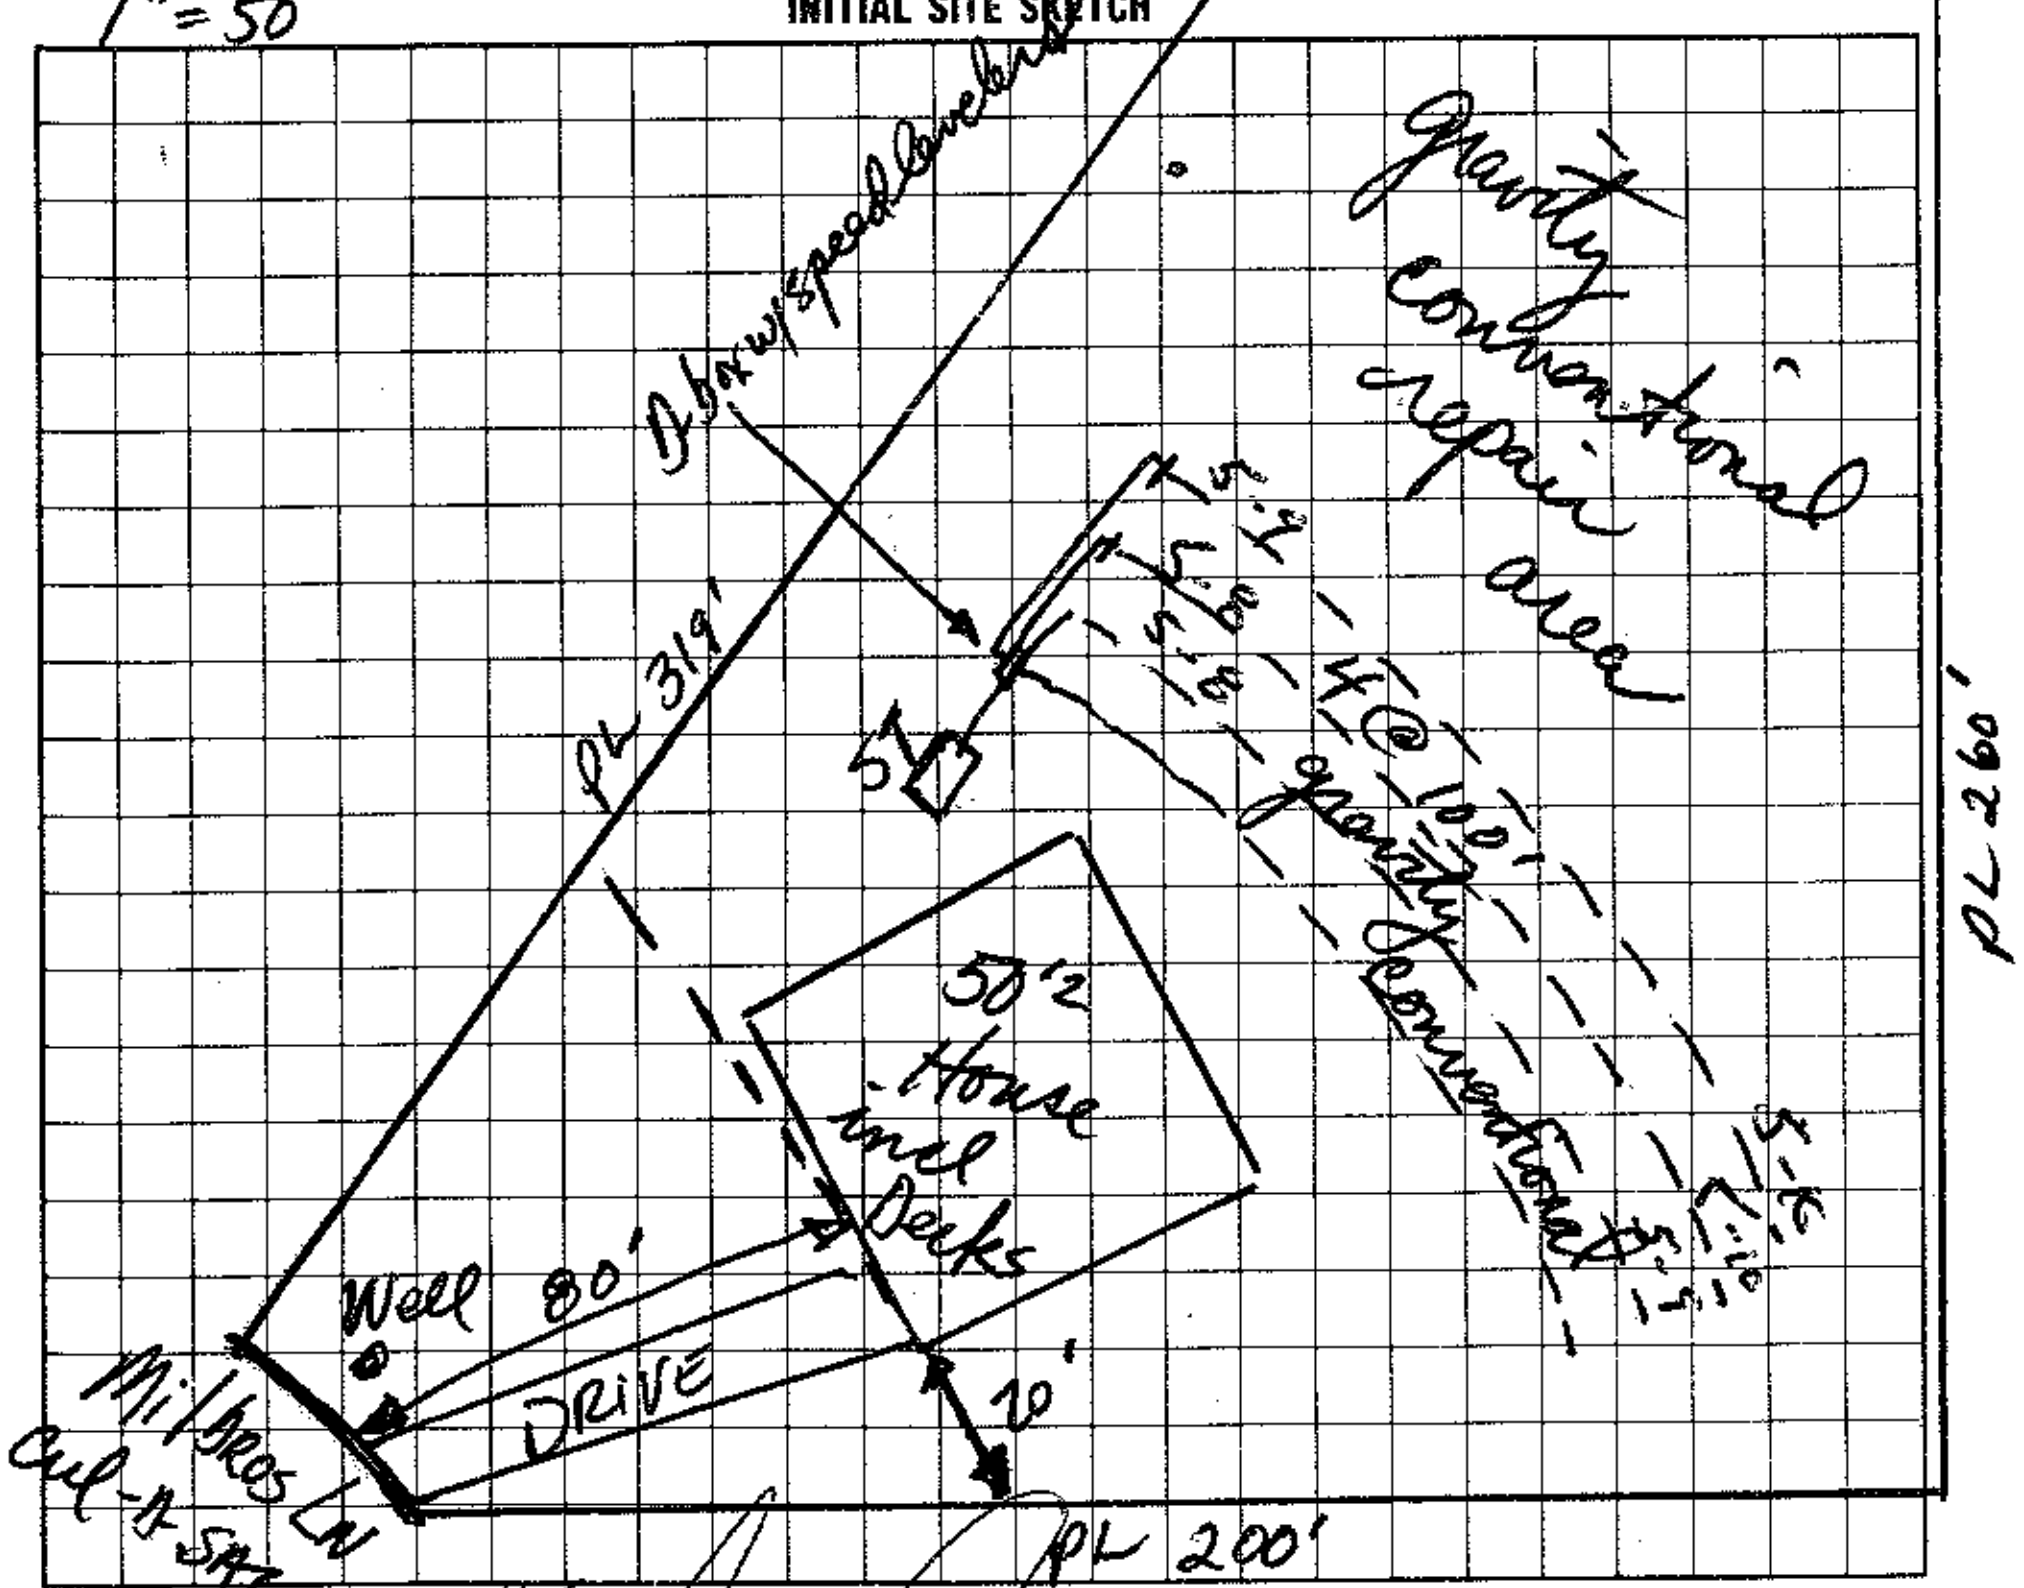

AS BUILT SKETCH

I understand that this permit can be suspended or revoked if any false information is supplied toward securing the permit/any unauthorized changes are made to the site/any unauthorized changes are made in the installation of the system.

Signed:

Installed by: Rowan Septic Tank

Improvement Permit by: David R. Hansen, RS date 12-18-95

Certificate of Completion by: date

Authorization to construct by: D. Hansen, RS date Jan 11, '96

Existing System Inspection by:

Operation Permit by: Wesley Sparks RS. date 6/21/96

DEPT. COPY: WHITE INSPECTION COPY (FINAL): GREEN OWNER COPY (FINAL): YELLOW INSPECTION COPY (INITIAL): PINK OWNER COPY (INITIAL): GOLD