IREDELL COUNTY HEALTH DEPARTMENT

STATESVILLE 704-878-5305 MOORESVILLE 704-664-5281

IMPROVEMENT PERMIT / CERTIFICATE OF COMPLETION / OPERATION PERMIT / EXISTING SYSTEM INSPECTION

PROPERTY DESCRIPTION NO. 22193 DATE Dec 19, '95 TAX MAP NO. part of 2545 # 4638 99 4176 Watershed: ☐ Yes ☐ No

OWNER OR CONTRACTOR Krom Financial Services PHONE: Business _____ Home _____

ADDRESS 109 Yacht Cove Rd. Mooresville

LOCATION Cornelius Rd. Turn on Creekview to Mikron Ct. on left

SUBDIVISION Mills Pond BLOCK / SECTION 2 LOT 64 LOT AREA .56 Ac SITE CLASS PS DESIGN FLOW 360 gpd E.T.A.R. .3

Septic Tank: 1000 Gallons; STB 625 Date 7/12/96 ☐ New System ☐ Repair System Type: I, II, III, IV, V, VI ☐ House/Mod. Home No. Bedrooms 3 Water Supply: ☑ Individual

Pump Tank: 1000 Gallons; PT 47 Date 8/3/96 System Description: pumped/pressure/conventional ☐ Mobile Home No. Bathrooms 2 ☐ Community

Pump Make: Zoeller Model N98-8 Serial No. PN 98-0002 Repair System Description: pumped Infiltrator ☐ Business No. Employees _____ ☐ Public

Nitrification Field: No Fields 1 Square Feet 720 Linear Feet 400 Maintenance Agreement Required: ☐ Yes ☑ No ☐ Other _____


No Lines 4@40' Trench Width 36" Max Trench Bottom Depth 36" Gravel Depth 12" ☐ Slab ☑ Crawl Space ☐ Basement w/plumbing ☐ Basement wo/plumbing

Comments:

Comments: Installed as shown on Curb Cost.

1" = 50'

INITIAL SITE SKETCH

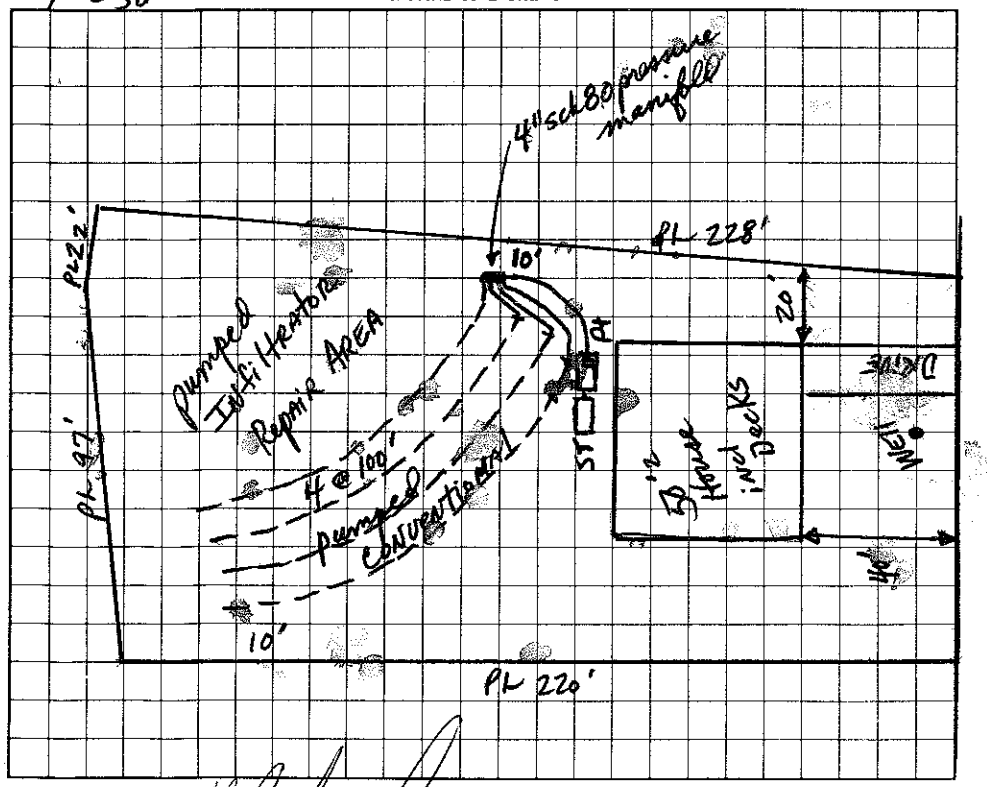

AS BUILT SKETCH

I understand that this permit can be suspended or revoked if any false information is supplied toward securing the permit/any unauthorized changes are made to the site/any unauthorized changes are made in the installation of the system.

Signed: _____

Improvement Permit by: _____ date 12-19-95

Existing System Inspection by: _____ date Jan 11, '96

Authorization to construct

Installed by: Rowan Septic Tank

Certificate of Completion by: _____ date _____

Operation Permit by: Wesley Sparks R.S. date 10/10/96

HEALTH DEPT. COPY: WHITE INSPECTION COPY (FINAL): GREEN OWNER COPY (FINAL): YELLOW INSPECTION COPY (INITIAL): PINK OWNER COPY (INITIAL): GOLD