IREDELL COUNTY HEALTH DEPARTMENT

STATESVILLE 704-878-5305 MOORESVILLE 704-664-5281

IMPROVEMENT PERMIT / CERTIFICATE OF COMPLETION / OPERATION PERMIT / EXISTING SYSTEM INSPECTION

PROPERTY DESCRIPTION NO. 22192 DATE Dec. 19, '95 TAX MAP NO. part of 2SA51 4638 99 5272 Watershed: ☑ Yes ☐ No

OWNER OR CONTRACTOR Krom Financial Services PHONE: Business _____ Home _____ WS4CA

ADDRESS 149 Yacht Cove Rd., Mooresville

LOCATION Conniers Rd. - Turn on Creekview Cov. - TL Mikes Ct. on left

SUBDIVISION Mills Pond BLOCK / SECTION 2 LOT 63 LOT AREA .65 AC SITE CLASS. RS DESIGN FLOW 360 gpd L.T.A.R. .3

Septic Tank: 1000 Gallons; STB 828 Date 10/7/95
Pump Tank: 1000 Gallons; PT 47 Date 12/11/95
Pump Make: Zoeller Model N 131-L Serial No. Lowes
Nitrification Field: No Fields 1 Square Feet 1200 Linear Feet 400
No Lines 3 @ 100' Trench Width 36" Max Trench Bottom Depth 36" Gravel Depth 12"

☑ New System ☐ Repair System Type: I, II, III, IV, V, VI
System Description: pumped/pm/conventional
Repair System Description: same
Maintenance Agreement Required: ☐ Yes ☑ No

☑ House/Mod. Home No. Bedrooms 3
☐ Mobile Home No. Bathrooms 2
☐ Business No. Employees _____
☐ Other _____
☐ Slab ☑ Crawl Space ☐ Basement w/plumbing ☐ Basement wo/plumbing


Water Supply:
☑ Individual
☐ Community
☐ Public

Comments:

Comments:

1" ≈ 50'

INITIAL SITE SKETCH

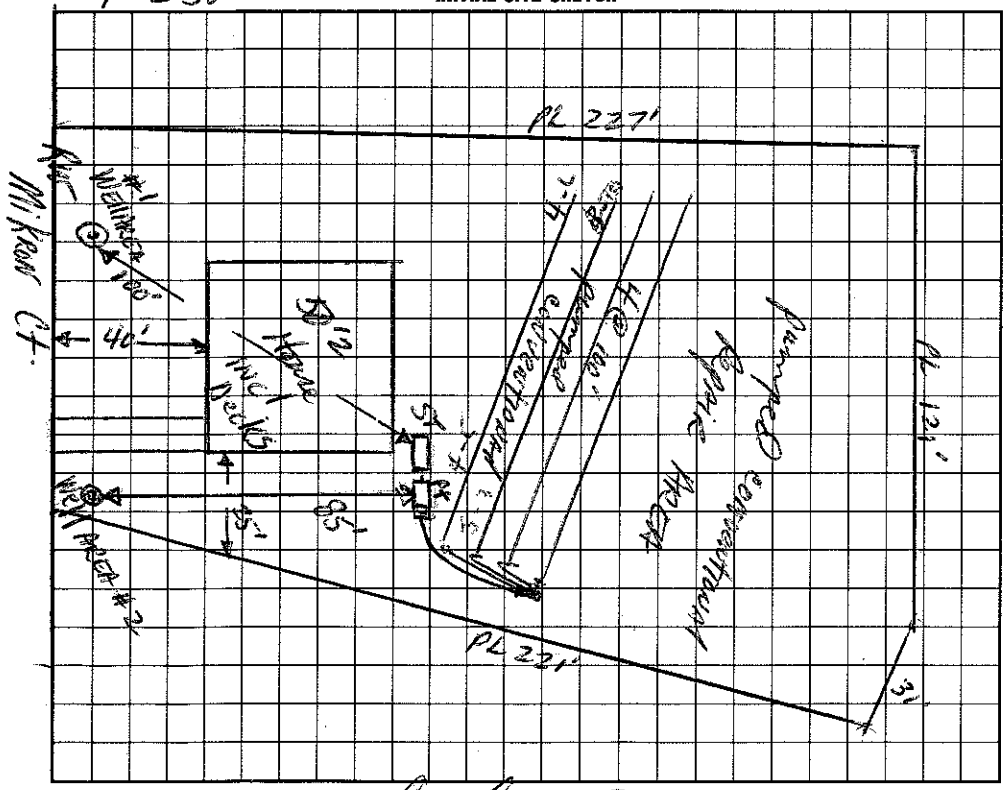

AS BUILT SKETCH

I understand that this permit can be suspended or revoked if any false information is supplied toward securing the permit/any unauthorized changes are made to the site/any unauthorized changes are made in the installation of the system.

Signed: [signature]

Improvement Permit by: D. Hanson, RS date 12-19-95

~~Existing System Inspection by:~~ D. Hanson, RS date 12-21-95

Authorized to Construct

Installed by: Rowan Septic Tank

Certificate of Completion by: Wesley Sparks RS date 2/28/96

Operation Permit by: Wesley Sparks RS. date 2/28/96

HEALTH DEPT. COPY: WHITE INSPECTION COPY (FINAL): GREEN OWNER COPY (FINAL): YELLOW INSPECTION COPY (INITIAL): PINK OWNER COPY (INITIAL): GOLD