IREDELL COUNTY HEALTH DEPARTMENT

STATESVILLE 704-878-5305 MOORESVILLE 704-664-5281

IMPROVEMENT PERMIT / CERTIFICATE OF COMPLETION / OPERATION PERMIT / EXISTING SYSTEM INSPECTION

PROPERTY DESCRIPTION NO. 22192 DATE Dec. 19, '95 TAX MAP NO. part of 7725A51 4638995272 Watershed: ☑ Yes ☐ No

OWNER OR CONTRACTOR Kuss Financial Services PHONE: Business _____ Home _____ WS4CA

ADDRESS 149 Yacht Cove Rd., Mooresville

LOCATION Cornelius Rd. Turn on Creekgreen Ln. TL Mikeal Ct. on left

SUBDIVISION Mills Pond BLOCK / SECTION 2 LOT 63 LOT AREA .165Ac SITE CLASS. RS DESIGN FLOW 360 gpd L.T.A.R. .3

Septic Tank: 1000 Gallons; STB 825 Date 10/7/95

Pump Tank: 1000 Gallons; PT 47 Date 12/11/95

Pump Make: Zoeller Model N 131-L Serial No. Unknown

Nitrification Field: No Fields 1 Square Feet 1200 Linear Feet 400

No Lines 3@100' Trench Width 36" Max Trench Bottom Depth 36" Gravel Depth 12"

☑ New System ☐ Repair System Type: I, II, (III) IV, V, VI

System Description: pumped/pm/conventional

Repair System Description: same

Maintenance Agreement Required: ☐ Yes ☑ No

☑ House/Mod. Home No. Bedrooms 3

☐ Mobile Home No. Bathrooms 2

☐ Business No. Employees ____

☐ Other ____

☐ Slab ☑ Crawl Space ☐ Basement w/plumbing ☐ Basement wo/plumbing


Water Supply: ☑ Individual ☐ Community ☐ Public

Comments:

Comments:

1" ≈ 50'

INITIAL SITE SKETCH

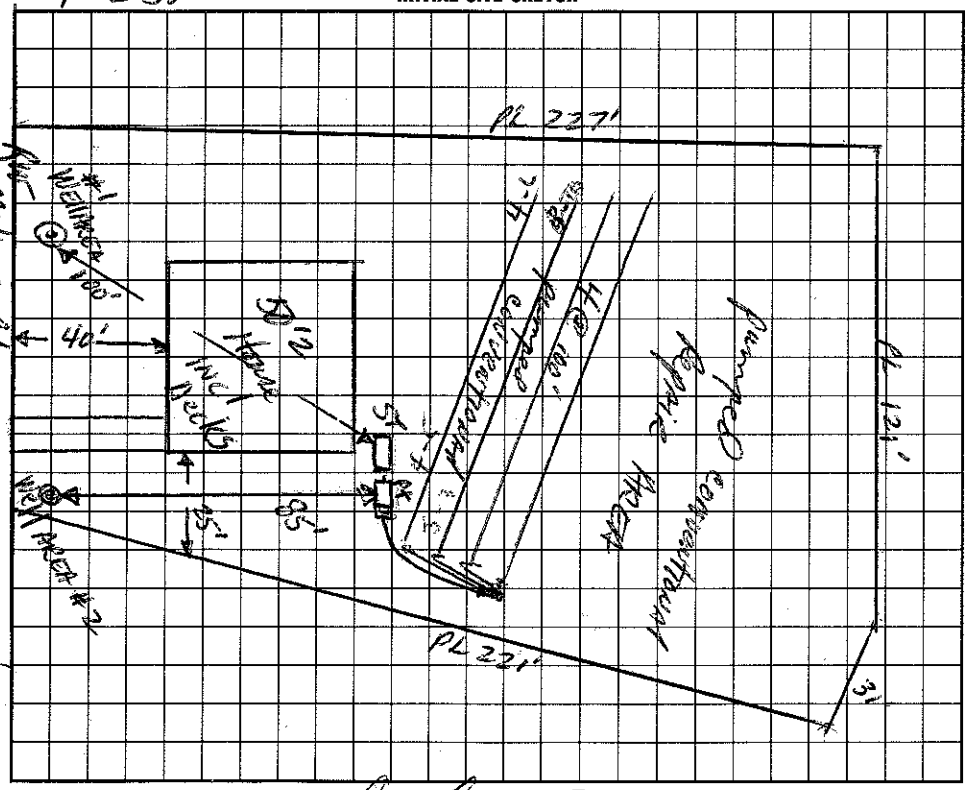

AS BUILT SKETCH

I understand that this permit can be suspended or revoked if any false information is supplied toward securing the permit/any unauthorized changes are made to the site/any unauthorized changes are made in the installation of the system.

Signed: _____

Improvement Permit by: _____, RS date 12-19-95

~~Existing System Inspection by:~~ _____, RS date 12-21-95

Authorization to Construct

Installed by: Rowan Septic Tanks

Certificate of Completion by: Wesley Sparks RS date 2/28/96

Operation Permit by: Wesley Sparks RS. date 2/28/96

HEALTH DEPT. COPY: WHITE INSPECTION COPY (FINAL): GREEN OWNER COPY (FINAL): YELLOW INSPECTION COPY (INITIAL): PINK OWNER COPY (INITIAL): GOLD