IREDELL COUNTY HEALTH DEPARTMENT

STATESVILLE 704-878-5305 MOORESVILLE 704-664-5281

IMPROVEMENT PERMIT / CERTIFICATE OF COMPLETION / OPERATION PERMIT / EXISTING SYSTEM INSPECTION

PROPERTY DESCRIPTION NO. 2054/6 DATE April 23, '95 TAX MAP NO. part of P25A57 Watershed: ☒ Yes ☐ No WSIII

OWNER OR CONTRACTOR Kyon Financial Services PHONE: Business 664-1367 Home

ADDRESS 19 Yacht Core Rd Mooresville 4638-99-5717

LOCATION Poplar Tent Rd. N. TR Cornelius Rd. TL Creek View Lane TL Viaduct Lane on left @ cul ASAC

SUBDIVISION Mills Pond BLOCK / SECTION LOT 73 LOT AREA SITE CLASS. DESIGN FLOW L.T.A.R.

Septic Tank: 1000 Gallons; STB 325 Date 6/27/97

Pump Tank: Gallons; PT Date

Pump Make: Model Serial No.

Nitrification Field: No Fields 1 Square Feet 1200 Linear Feet 400

No Lines 5 Trench Width 36" Max Trench Bottom Depth 36" Gravel Depth 12"

☒ New System ☐ Repair System Type: I, II, III, IV, V, VI

System Description: gravity Conventional

Repair System Description: upgrade INFILTRATOR

Maintenance Agreement Required: ☐ Yes ☒ No

☒ House/Mod. Home No. Bedrooms 3

☐ Mobile Home No. Bathrooms 2

☐ Business No. Employees

☐ Other

Water Supply: ☒ Individual ☐ Community ☐ Public


☐ Slab ☒ Crawl Space ☐ Basement w/plumbing ☐ Basement wo/plumbing

Comments:

Comments: DEVELOPER PERMANENT 9/23/95 RWS


1"=50'

INITIAL SITE SKETCH

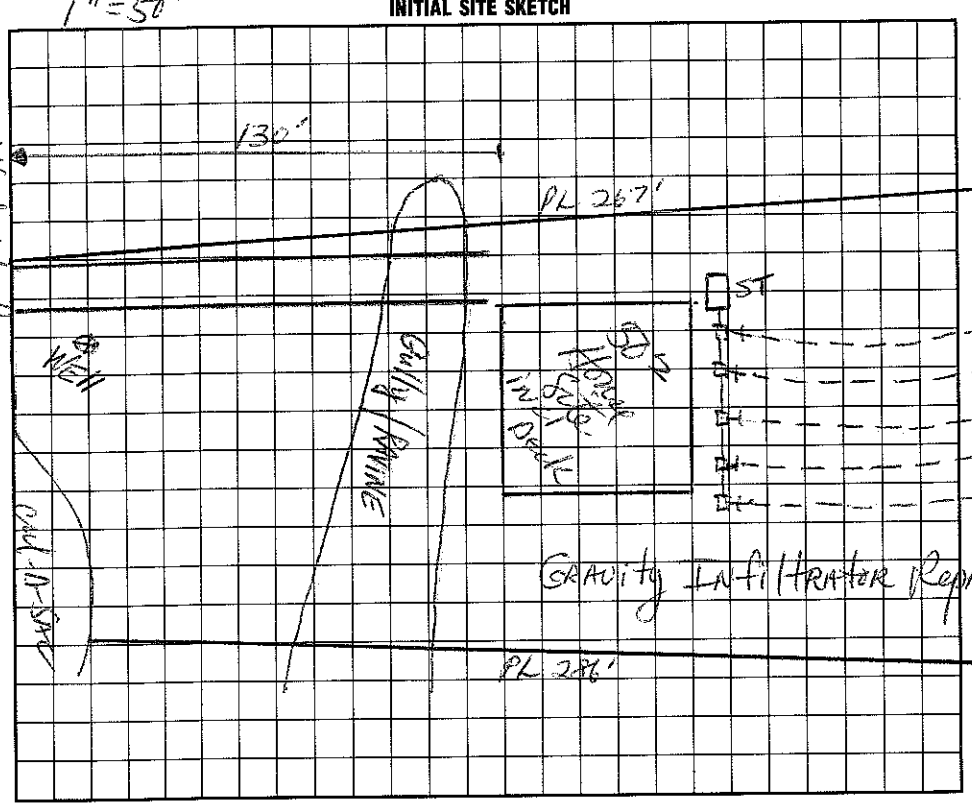

Wadsworth Lane

AS BUILT SKETCH

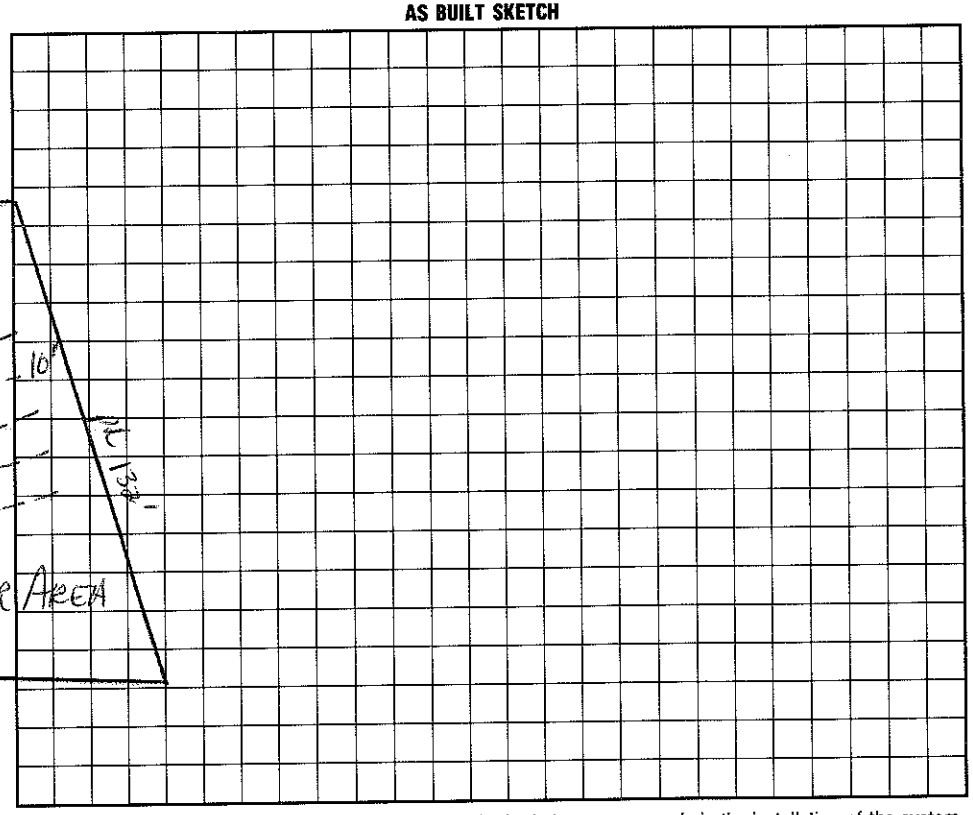

I understand that this permit can be suspended or revoked if any false information is supplied toward securing the permit/any unauthorized changes are made to the site/any unauthorized changes are made in the installation of the system. Improvement Permit is valid for 60 months from date of issuance.

Signed:

Improvement Permit by: RS date 4/23/95

Existing System Inspection by: date

Installed by: ROWAN SEPTIC

Certificate of Completion by: date

Operation Permit by: C. date 10/9/97

HEALTH DEPT. COPY: WHITE INSPECTION COPY (FINAL): GREEN OWNER COPY (FINAL): YELLOW INSPECTION COPY (INITIAL): PINK OWNER COPY (INITIAL): GOLD