IREDELL COUNTY HEALTH DEPARTMENT

4638-99-6286

STATESVILLE 704-878-5305 MOORESVILLE 704-664-5281

IMPROVEMENT PERMIT / CERTIFICATE OF COMPLETION / OPERATION PERMIT / EXISTING SYSTEM INSPECTION

PROPERTY DESCRIPTION NO. 22191 DATE Dec 19, '95 TAX MAP NO. part of 25A51 Watershed: ☑ Yes ☐ No

OWNER OR CONTRACTOR Krom Financial Services PHONE: Business / Home WS4CA

ADDRESS 149 Yacht Cove Rd., Mooresville

LOCATION Cragdup Rd. Turn on Creekview TL McKeon Ct. on left at cul-d-sac

SUBDIVISION Mills Pond BLOCK / SECTION LOT 62 LOT AREA .56 Ac SITE CLASS. PS per 1952 DESIGN FLOW 360gpd. L.T.A.R. .3

Septic Tank: 1000 Gallons; STB 825 Date 7/16/96

Pump Tank: Gallons; PT Date

Pump Make: Model Serial No.

Nitrification Field: No Fields 1 Square Feet 900 Linear Feet 300

No Lines 3 @ 100' Trench Width 36" Max Trench Bottom Depth 36" Gravel Depth N/A

☑ New System ☐ Repair System Type: I, II, (III), IV, V, VI

System Description: * Gravity Infiltrator

Repair System Description: Grav w/ Pumped Inf.

Maintenance Agreement Required: ☐ Yes ☑ No

☑ House/Mod. Home No. Bedrooms 3

☐ Mobile Home No. Bathrooms 2

☐ Business No. Employees

☐ Other

☐ Slab ☑ Crawl Space ☐ Basement w/plumbing ☐ Basement wo/plumbing


Water Supply: ☑ Individual ☐ Community ☐ Public

Comments: * Plumbing must exit at or slightly above existing grade where tank is shown in order to Avoid use of a pump.

Comments:

1" = 50'

INITIAL SITE SKETCH

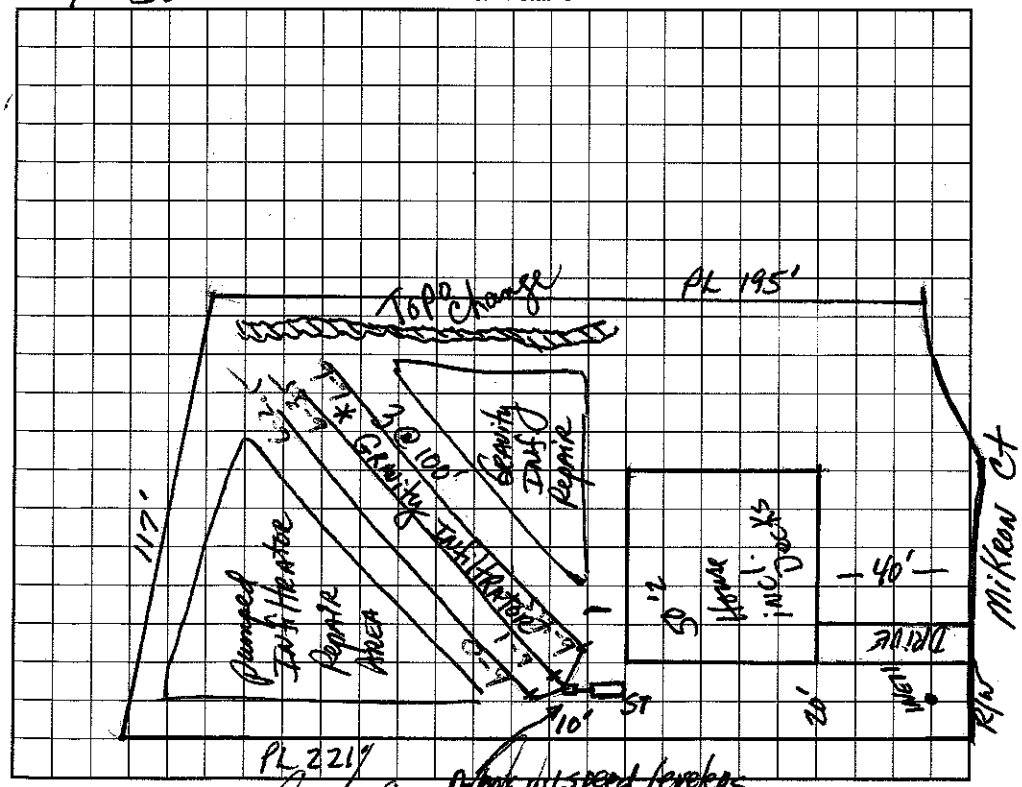

AS BUILT SKETCH

I understand that this permit can be suspended or revoked if any false information is supplied toward securing the permit/any unauthorized changes are made to the site/any unauthorized changes are made in the installation of the system.

Signed: *

Improvement Permit by: Jack R. Amos, RS date 12-19-95

Existing System Inspection by: Authorization to construct M. Amos, R.S. date Jan 11, '96

Installed by: Rowan Septic Tank

Certificate of Completion by: date

Operation Permit by: Wesley Sparks R.S. date 8/15/96

HEALTH DEPT. COPY: WHITE INSPECTION COPY (FINAL): GREEN OWNER COPY (FINAL): YELLOW INSPECTION COPY (INITIAL): PINK OWNER COPY (INITIAL): GOLD