IREDELL COUNTY HEALTH DEPARTMENT

STATESVILLE 704-878-5305 MOORESVILLE 704-664-5281

IMPROVEMENT PERMIT / CERTIFICATE OF COMPLETION / OPERATION PERMIT / EXISTING SYSTEM INSPECTIO

PROPERTY DESCRIPTION NO. 22197 DATE Jan 30, '96 TAX MAP NO. part of 2SA51 Watershed: ☑ Yes ☐ No

OWNER OR CONTRACTOR Krom Financial / Spear Construction PHONE: Business Home 463-99-7479

ADDRESS 149 Yacht Cove Rd. Mooresville

LOCATION Conelfuny Rd. Turn on Creekview Tr Wadsworth Ln. on right in cul-D-Sac

SUBDIVISION Mills Pond BLOCK / SECTION LOT 70 LOT AREA 1.14 Ac SITE CLASS. PS DESIGN FLOW 360 gpd L.T.A.R. .03

Septic Tank: 1000 Gallons; STB 825 Date 8/2/96

Pump Tank: Gallons; PT Date

Pump Make: Model Serial No.

Nitrification Field: No Fields 1 Square Feet 1200 Linear Feet 400

No Lines 3 @ 133' Trench Width 36" Max Trench Bottom Depth 30" Gravel Depth 12"

☑ New System ☐ Repair System Type: I, II, III, IV, V, VI

System Description: gravity conventional

Repair System Description: Same

Maintenance Agreement Required: ☐ Yes ☑ No

☑ House/Mod. Home No. Bedrooms 3

☐ Mobile Home No. Bathrooms 2

☐ Business No. Employees

☐ Other

☐ Slab ☑ Crawl Space ☐ Basement w/plumbing ☐ Basement wo/plumbing


Water Supply: ☑ Individual ☐ Community ☐ Public

Comments:

Comments:

1" = 50'

INITIAL SITE SKETCH

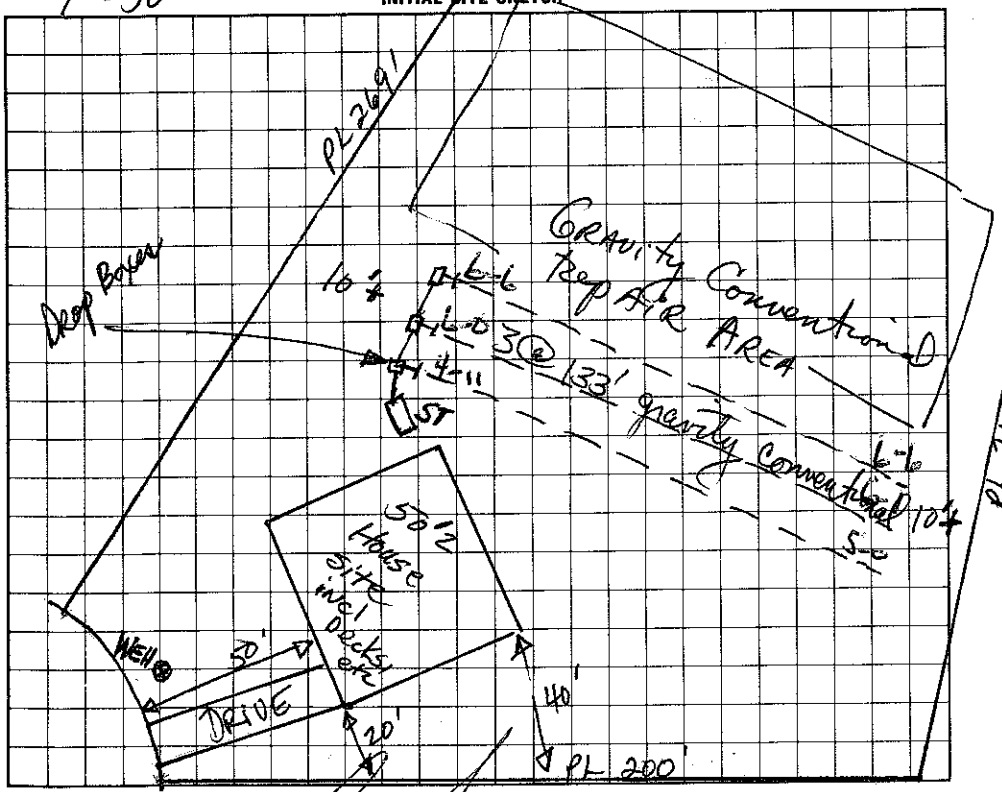

AS BUILT SKETCH

I understand that this permit can be suspended or revoked if any false information is supplied toward securing the permit/any unauthorized changes are made to the site/any unauthorized changes are made in the installation of the system.

Signed

Improvement Permit by: David L. Thompson RS date Jan 30, '96

Existing System Inspection by: David L. Thompson RS date Jan 30, '96

Authorization to construct

Installed by: Rowan Septic Tank

Certificate of Completion by: date

Operation Permit by: Wesley Sparks RS. date 11/6/96

HEALTH DEPT. COPY: WHITE INSPECTION COPY (FINAL): GREEN OWNER COPY (FINAL): YELLOW INSPECTION COPY (INITIAL): PINK OWNER COPY (INITIAL): GOLD