(3:30)

IREDELL COUNTY HEALTH DEPARTMENT

STATESVILLE 704-878-5305 MOORESVILLE 704-664-5281

IMPROVEMENT PERMIT / CERTIFICATE OF COMPLETION / OPERATION PERMIT / EXISTING SYSTEM INSPECTION

PROPERTY DESCRIPTION NO. 22199 DATE Dec 20, '95 TAX MAP NO. part of 2545/1 Watershed: ☑ Yes ☐ No

OWNER OR CONTRACTOR Krom Financial Services PHONE: Business Home WS4CA

ADDRESS 149 Yacht Cove Rd., Mooresville 4638-99-7647

LOCATION Cornelius Rd. Turn on Creekview TL Wadwick LN. on left in cul-d-sac

SUBDIVISION Mills Pond BLOCK / SECTION LOT 72 LOT AREA 1.38 ac SITE CLASS. PS DESIGN FLOW 360 gpd L.T.A.R. .3

Septic Tank: 1000 Gallons; STB 825 Date 7/11/97

Pump Tank: Gallons; PT Date

Pump Make: Model Serial No.

Nitrification Field: No. Fields 1 Square Feet 1200 Linear Feet 400

No. Lines 3@133' Trench Width 36" Max Trench Bottom Depth 36" Gravel Depth 12"

☑ New System ☐ Repair System Type: I, II, III, IV, V, VI

System Description: gravity conventional

Repair System Description: same

Maintenance Agreement Required: ☐ Yes ☑ No

☑ House/Mod. Home No. Bedrooms 3

☐ Mobile Home No. Bathrooms 2

☐ Business No. Employees

☐ Other


☐ Slab ☑ Crawl Space ☐ Basement w/plumbing ☐ Basement wo/plumbing

Water Supply: ☑ Individual ☐ Community ☐ Public


Comments:

Comments:

INITIAL SITE SKETCH

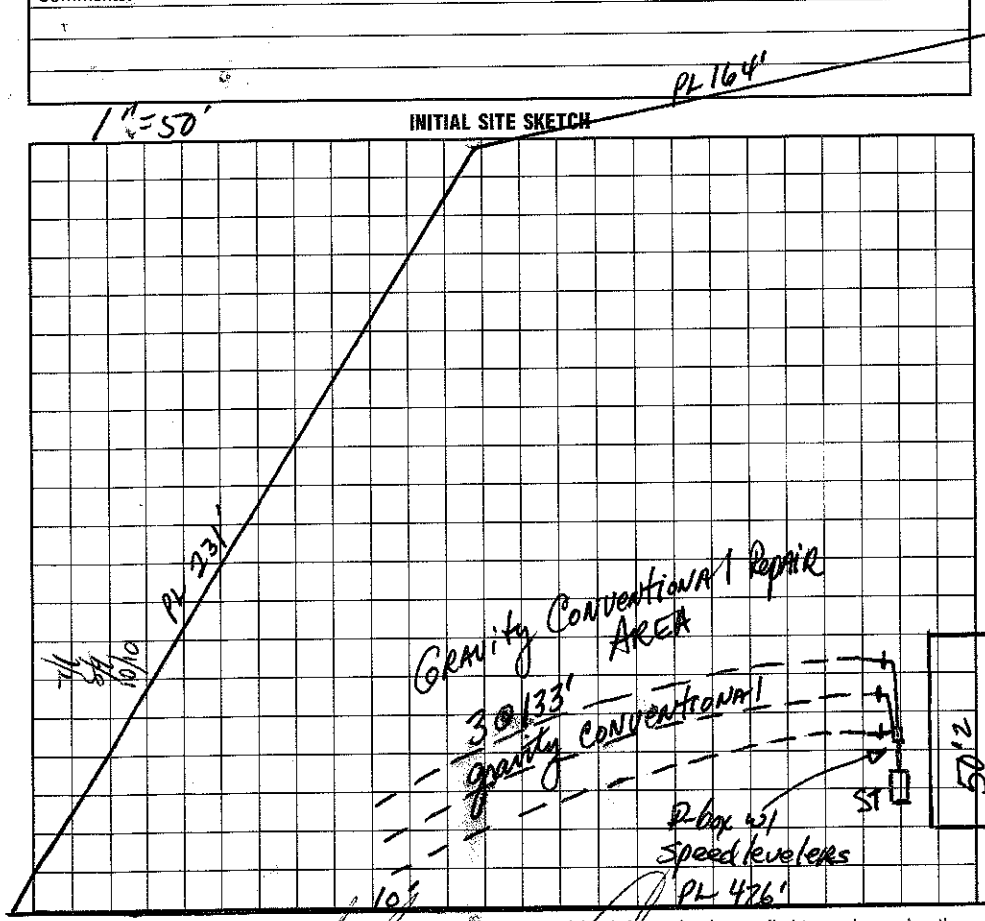

AS BUILT SKETCH

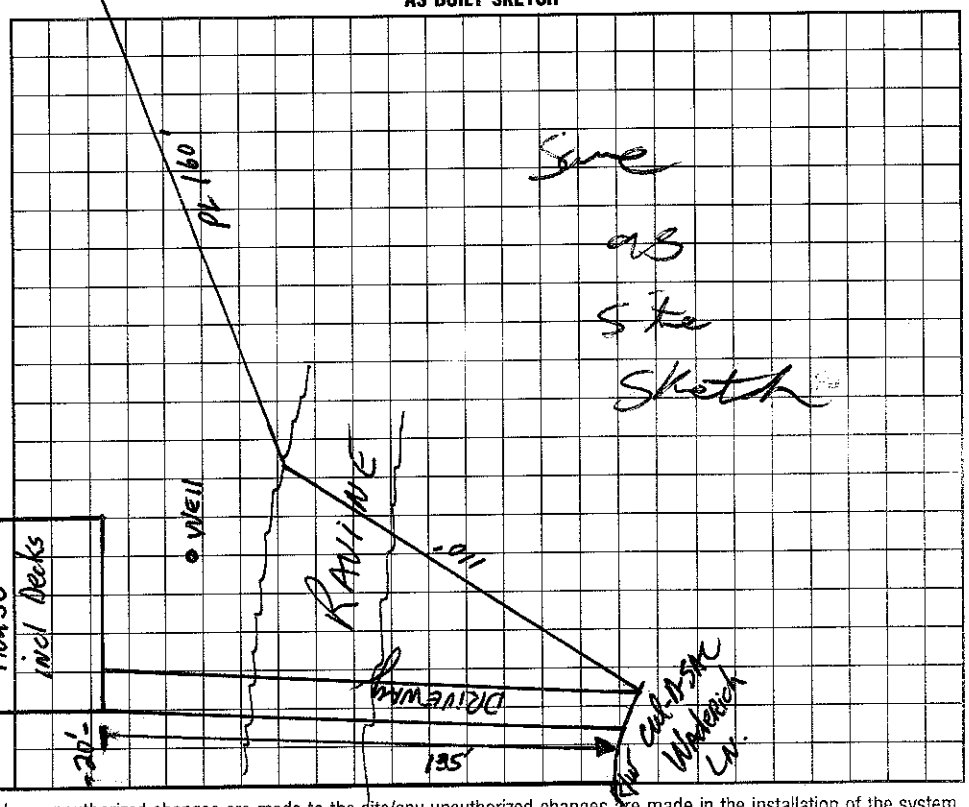

I understand that this permit can be suspended or revoked if any false information is supplied toward securing the permit/any unauthorized changes are made to the site/any unauthorized changes are made in the installation of the system.

Signed: X

Improvement Permit by: Jack R Thomason, RS date 12-20-95

Existing System Inspection by: Jack R Thomason, RS date Jan 11 '96

Installed by: ROWAN SEPTIC

Certificate of Completion by: date

Operation Permit by: C. Thomason date 8/27/97

HEALTH DEPT. COPY: WHITE INSPECTION COPY (FINAL): GREEN OWNER COPY (FINAL): YELLOW INSPECTION COPY (INITIAL): PINK OWNER COPY (INITIAL): GOLD