IREDELL COUNTY HEALTH DEPARTMENT

STATESVILLE 704-878-5305 MOORESVILLE 704-664-5281

IMPROVEMENT PERMIT / CERTIFICATE OF COMPLETION / OPERATION PERMIT / EXISTING SYSTEM INSPECTION

PROPERTY DESCRIPTION NO. 22187 DATE Dec 12, '95 TAX MAP NO. part of 25A51 Watershed: ☐ Yes ☐ No

OWNER OR CONTRACTOR Krom Financial Services PHONE: Business ______ Home ______

ADDRESS 149 Yacht Cove Rd, Mooresville 4638-99-8061

LOCATION Cornelius Rd. TL Creekview TL Mikron ct. on Right in cul-D-Sac

SUBDIVISION Mills Pond BLOCK / SECTION ______ LOT 58 LOT AREA .66 Ac SITE CLASS. PS DESIGN FLOW 360 gpd L.T.A.R. .3+

Septic Tank: 1000 Gallons; STB 825 Date 4/10/96

Pump Tank: ______ Gallons; PT ______ Date ______

Pump Make: ______ Model ______ Serial No. ______

Nitrification Field: No Fields 1 Square Feet 1200 Linear Feet 400

No Lines 4@100' Trench Width 36" Max Trench Bottom Depth 36" Gravel Depth 12"

☑ New System ☐ Repair System Type: I, (II), III, IV, V, VI

System Description: gravity conventional

Repair System Description: grav conv. or Inf

Maintenance Agreement Required: ☐ Yes ☑ No

☑ House/Mod. Home No. Bedrooms 3

☐ Mobile Home No. Bathrooms 2

☐ Business No. Employees ______

☐ Other ______


☐ Slab ☑ Crawl Space ☐ Basement w/plumbing ☐ Basement wo/plumbing

Water Supply: ☑ Individual ☐ Community ☐ Public

Comments:

Comments:

INITIAL SITE SKETCH

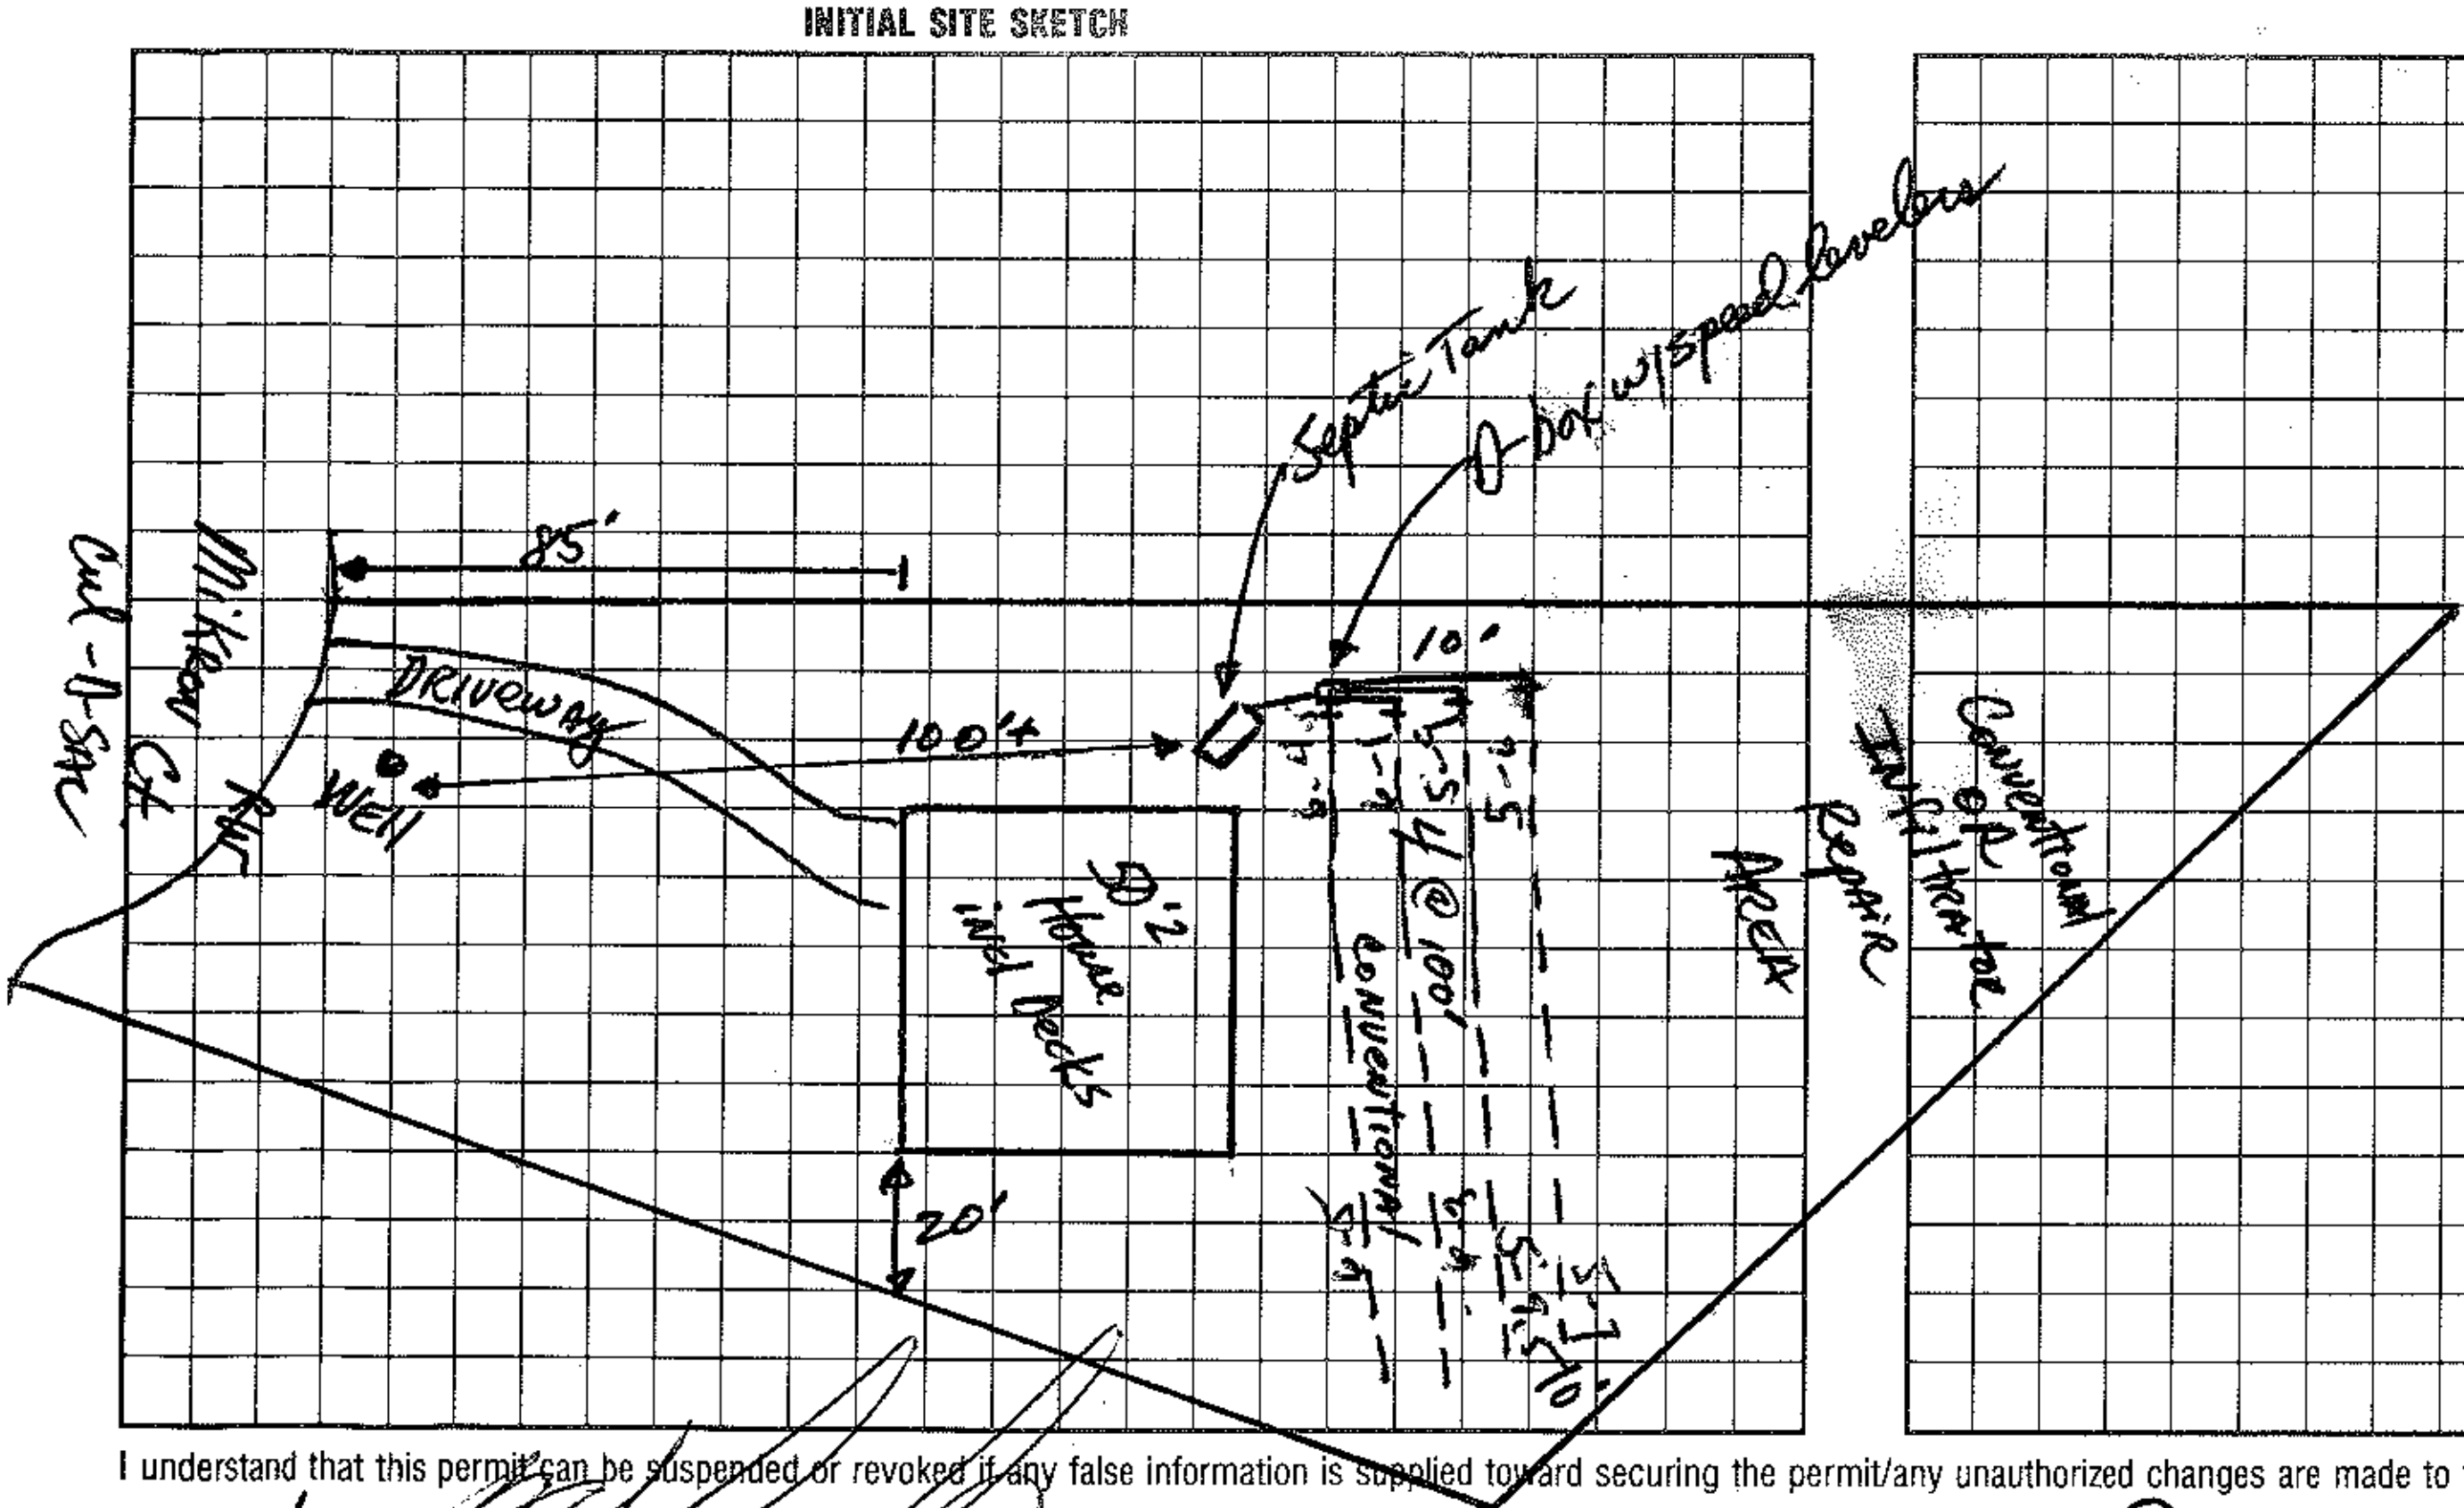

AS BUILT SKETCH

I understand that this permit can be suspended or revoked if any false information is supplied toward securing the permit/any unauthorized changes are made to the site/any unauthorized changes are made in the installation of the system.

Signed: X [signature]

Installed by: Rowan Septic Tank

Improvement Permit by: [signature], RS date 12-12-95

Certificate of Completion by: ______ date ______

Existing System Inspection by: [signature], RS date Jan 11, '96 (Authorization to construct)

Operation Permit by: Wesley Sparks, R.S. date 6/24/96

HEALTH DEPT. COPY: WHITE INSPECTION COPY (FINAL): GREEN OWNER COPY (FINAL): YELLOW INSPECTION COPY (INITIAL): PINK OWNER COPY (INITIAL): GOLD