IREDELL COUNTY HEALTH DEPARTMENT

STATESVILLE 704-878-5305 MOORESVILLE 704-664-5281

IMPROVEMENT PERMIT / CERTIFICATE OF COMPLETION / OPERATION PERMIT / EXISTING SYSTEM INSPECTION

PROPERTY DESCRIPTION NO. 22190 DATE Jan. 30, '96 TAX MAP NO. part of 2545/ Watershed: ☐ Yes ☐ No

OWNER OR CONTRACTOR Kuon Financial PHONE: Business Home

ADDRESS 169 Yacht Cove Rd. / Mooresville 4638-99-8353

LOCATION Cornelius Rd. Turn on Creekview TL Mikron Ct. on left at end

SUBDIVISION Mills Pond BLOCK / SECTION LOT 61 LOT AREA .87Ac SITE CLASS PS DESIGN FLOW 360gpd L.T.A.R. .3

Septic Tank: 1000 Gallons; STB 825 Date 7/17/96

Pump Tank: Gallons; PT Date

Pump Make: Model Serial No.

Nitrification Field: No Fields 1 Square Feet 1200 Linear Feet 400

No Lines 4@100'± Trench Width 36" Max Trench Bottom Depth 30" Gravel Depth 12"

☑ New System ☐ Repair System Type: I, II, III, IV, V, VI

System Description: gravity conventional

Repair System Description: same

Maintenance Agreement Required: ☐ Yes ☑ No

☑ House/Mod. Home No. Bedrooms 3

☐ Mobile Home No. Bathrooms 2

☐ Business No. Employees

☐ Other


☐ Slab ☑ Crawl Space ☐ Basement w/plumbing ☐ Basement wo/plumbing

Water Supply: ☑ Individual ☐ Community ☐ Public

Comments:

Comments: Installed as shown on Const. Auth.

INITIAL SITE SKETCH 1"=50'

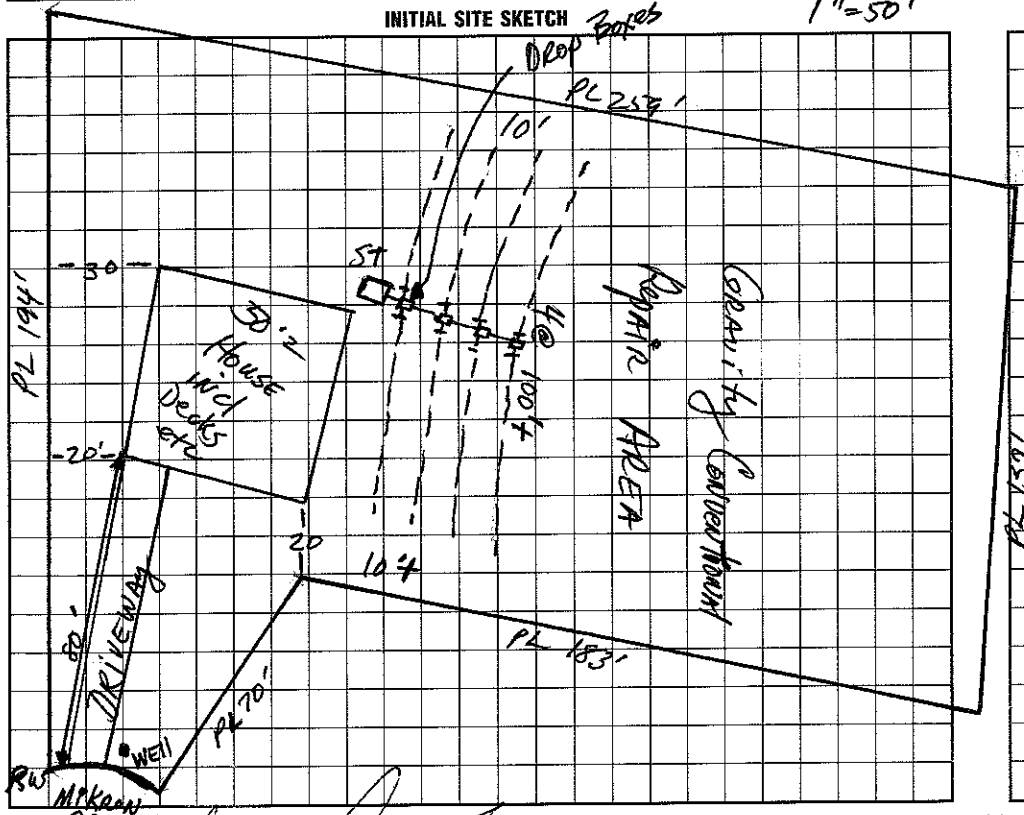

AS BUILT SKETCH

I understand that this permit can be suspended or revoked if any false information is supplied toward securing the permit/any unauthorized changes are made to the site/any unauthorized changes are made in the installation of the system.

Signed: X

Improvement Permit by: Barry Patterson RS date Jan 30, '96

Existing System Inspection by: Authorization to construct B Patterson RS date 1-30-96

Installed by: Rowen Septic Tank

Certificate of Completion by: date

Operation Permit by: Wesley Sparks R.S. date 10/14/96

APPL. COPY: WHITE INSPECTION COPY (FINAL): GREEN OWNER COPY (FINAL): YELLOW INSPECTION COPY (INITIAL): PINK OWNER COPY (INITIAL): GOLD