IREDELL COUNTY HEALTH DEPARTMENT

STATESVILLE 704-878-5305 MOORESVILLE 704-664-5281

IMPROVEMENT PERMIT / CERTIFICATE OF COMPLETION / OPERATION PERMIT / EXISTING SYSTEM INSPECTION

PROPERTY DESCRIPTION NO. 22189 DATE Dec 19, '95 TAX MAP NO. part of 25A51 Watershed: ☑ Yes ☐ No WS4CA

OWNER OR CONTRACTOR Krom Financial Services PHONE: Business Home

ADDRESS 149 Yacht Cove Rd., Mooresville 4638-99-9212

LOCATION Cornelius Rd. Turn on Creekview TL Mikron Ct. at end

SUBDIVISION Mills Pond BLOCK / SECTION LOT 60 LOT AREA .62 Ac SITE CLASS. PS DESIGN FLOW 360 gpd L.T.A.R. .3

Septic Tank: 1000 Gallons; STB 825 Date 7-8-96
Pump Tank: Gallons; PT Date
Pump Make: Model Serial No.
Nitrification Field: No Fields 1 Square Feet 1200 Linear Feet 400
No Lines 4@100' Trench Width 36" Max Trench Bottom Depth 36" Gravel Depth 12"

☑ New System ☐ Repair System Type: I II III IV V VI
System Description: gravity conventional
Repair System Description: gravity Infiltrator
Maintenance Agreement Required: ☐ Yes ☑ No

☑ House/Mod. Home ☐ Mobile Home ☐ Business ☐ Other
No. Bedrooms 3 No. Bathrooms 2 No. Employees
☐ Slab ☑ Crawl Space ☐ Basement w/plumbing ☐ Basement wo/plumbing


Water Supply: ☑ Individual ☐ Community ☐ Public

Comments:


Comments:

1" = 50'

INITIAL SITE SKETCH

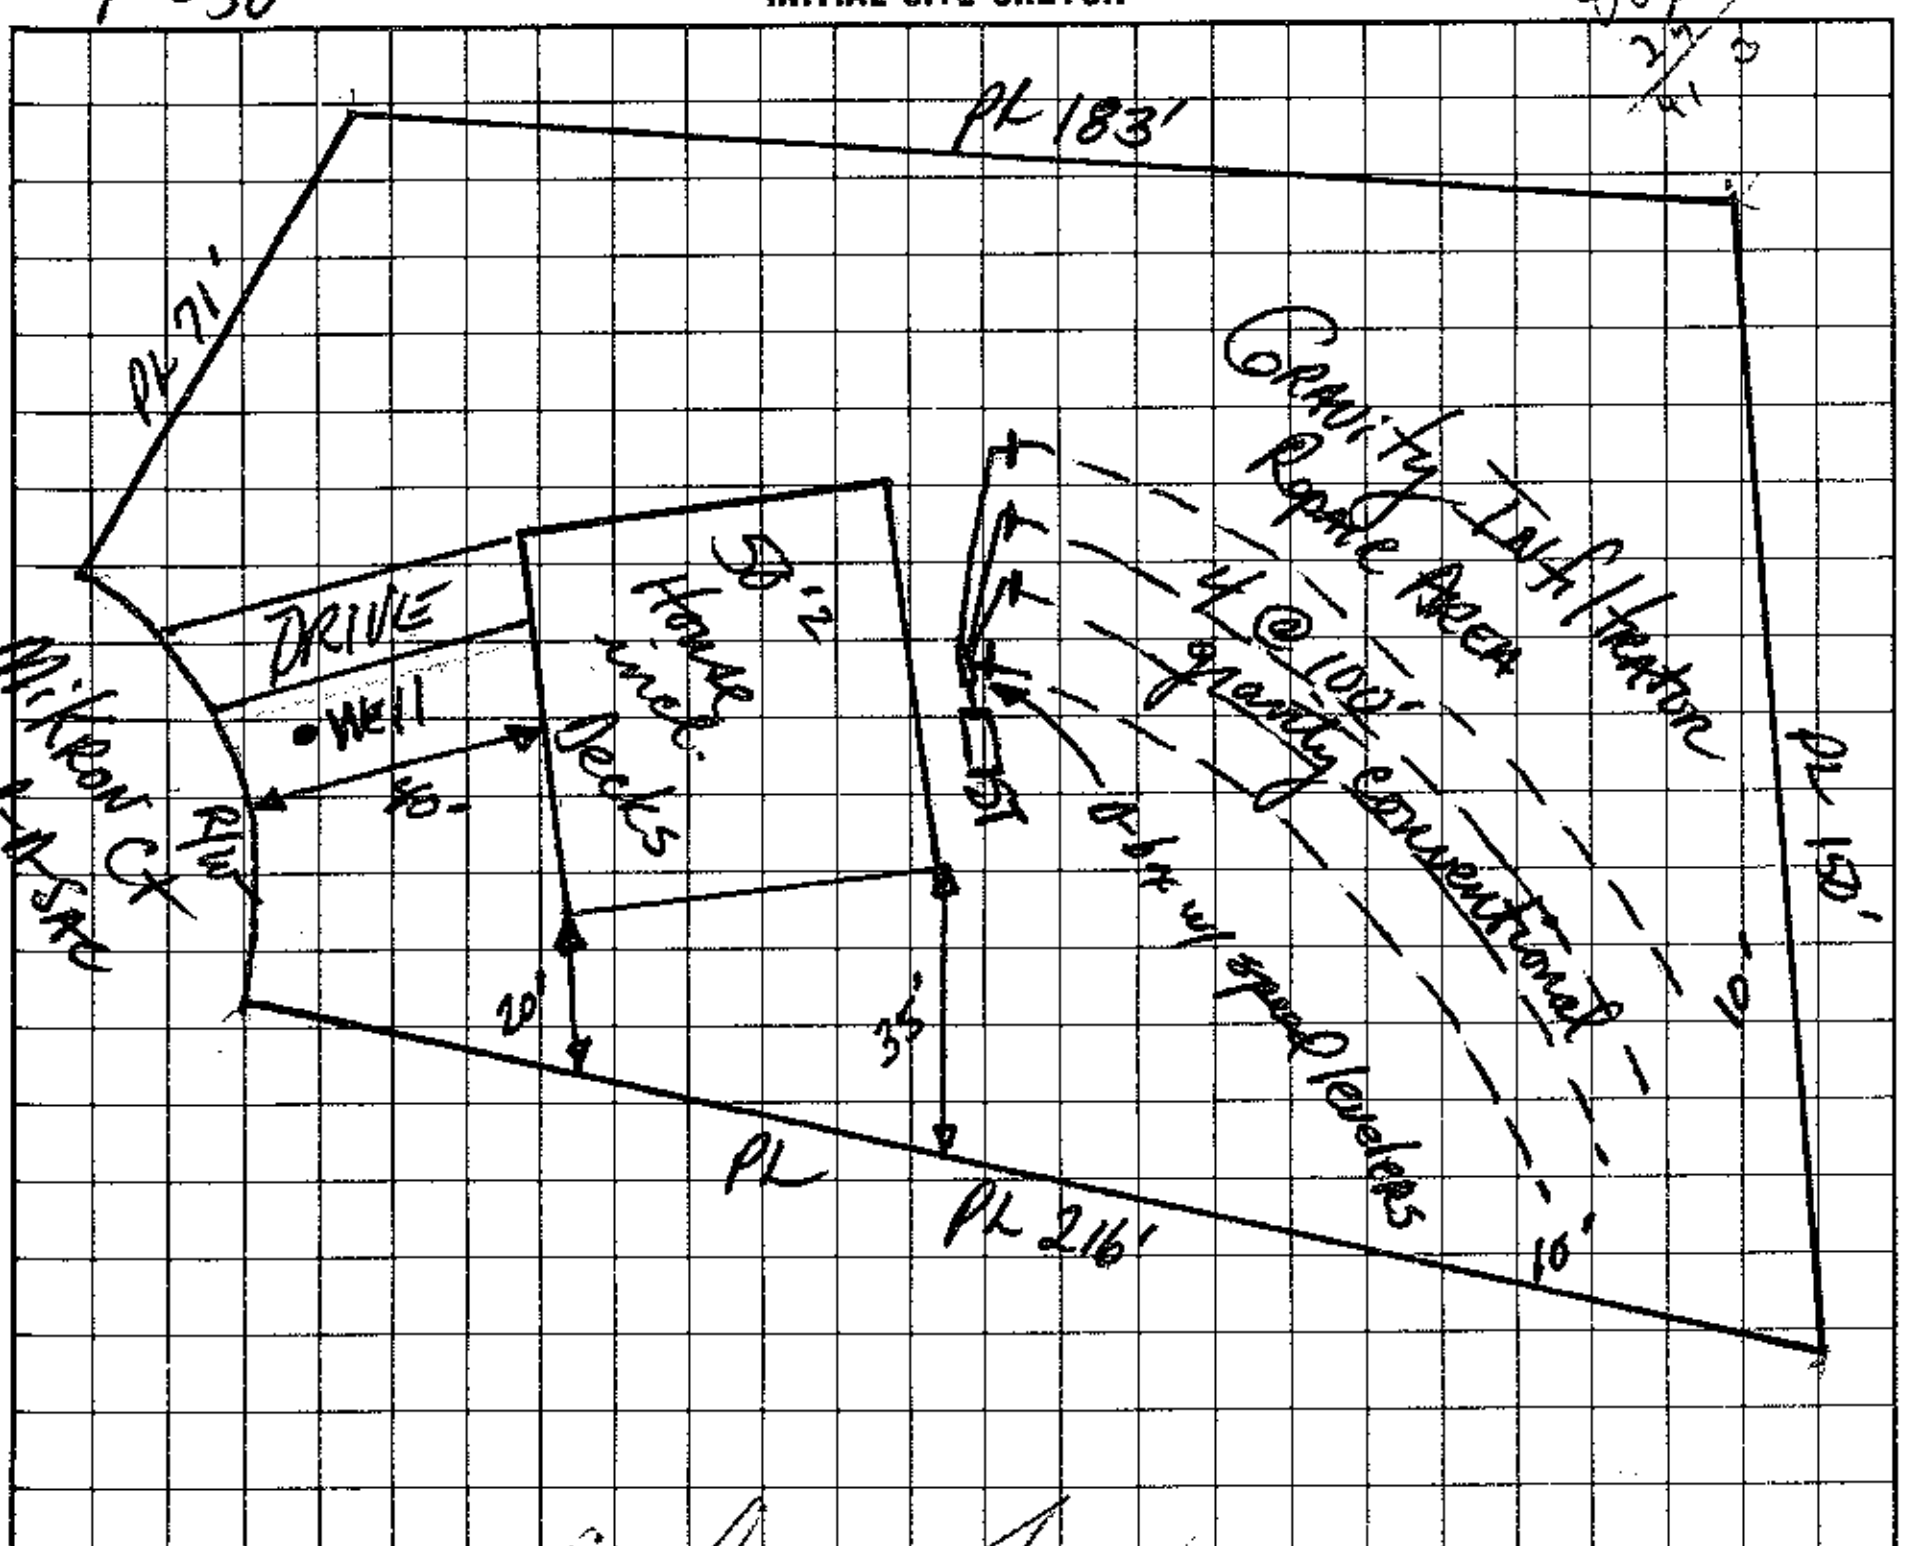

AS BUILT SKETCH

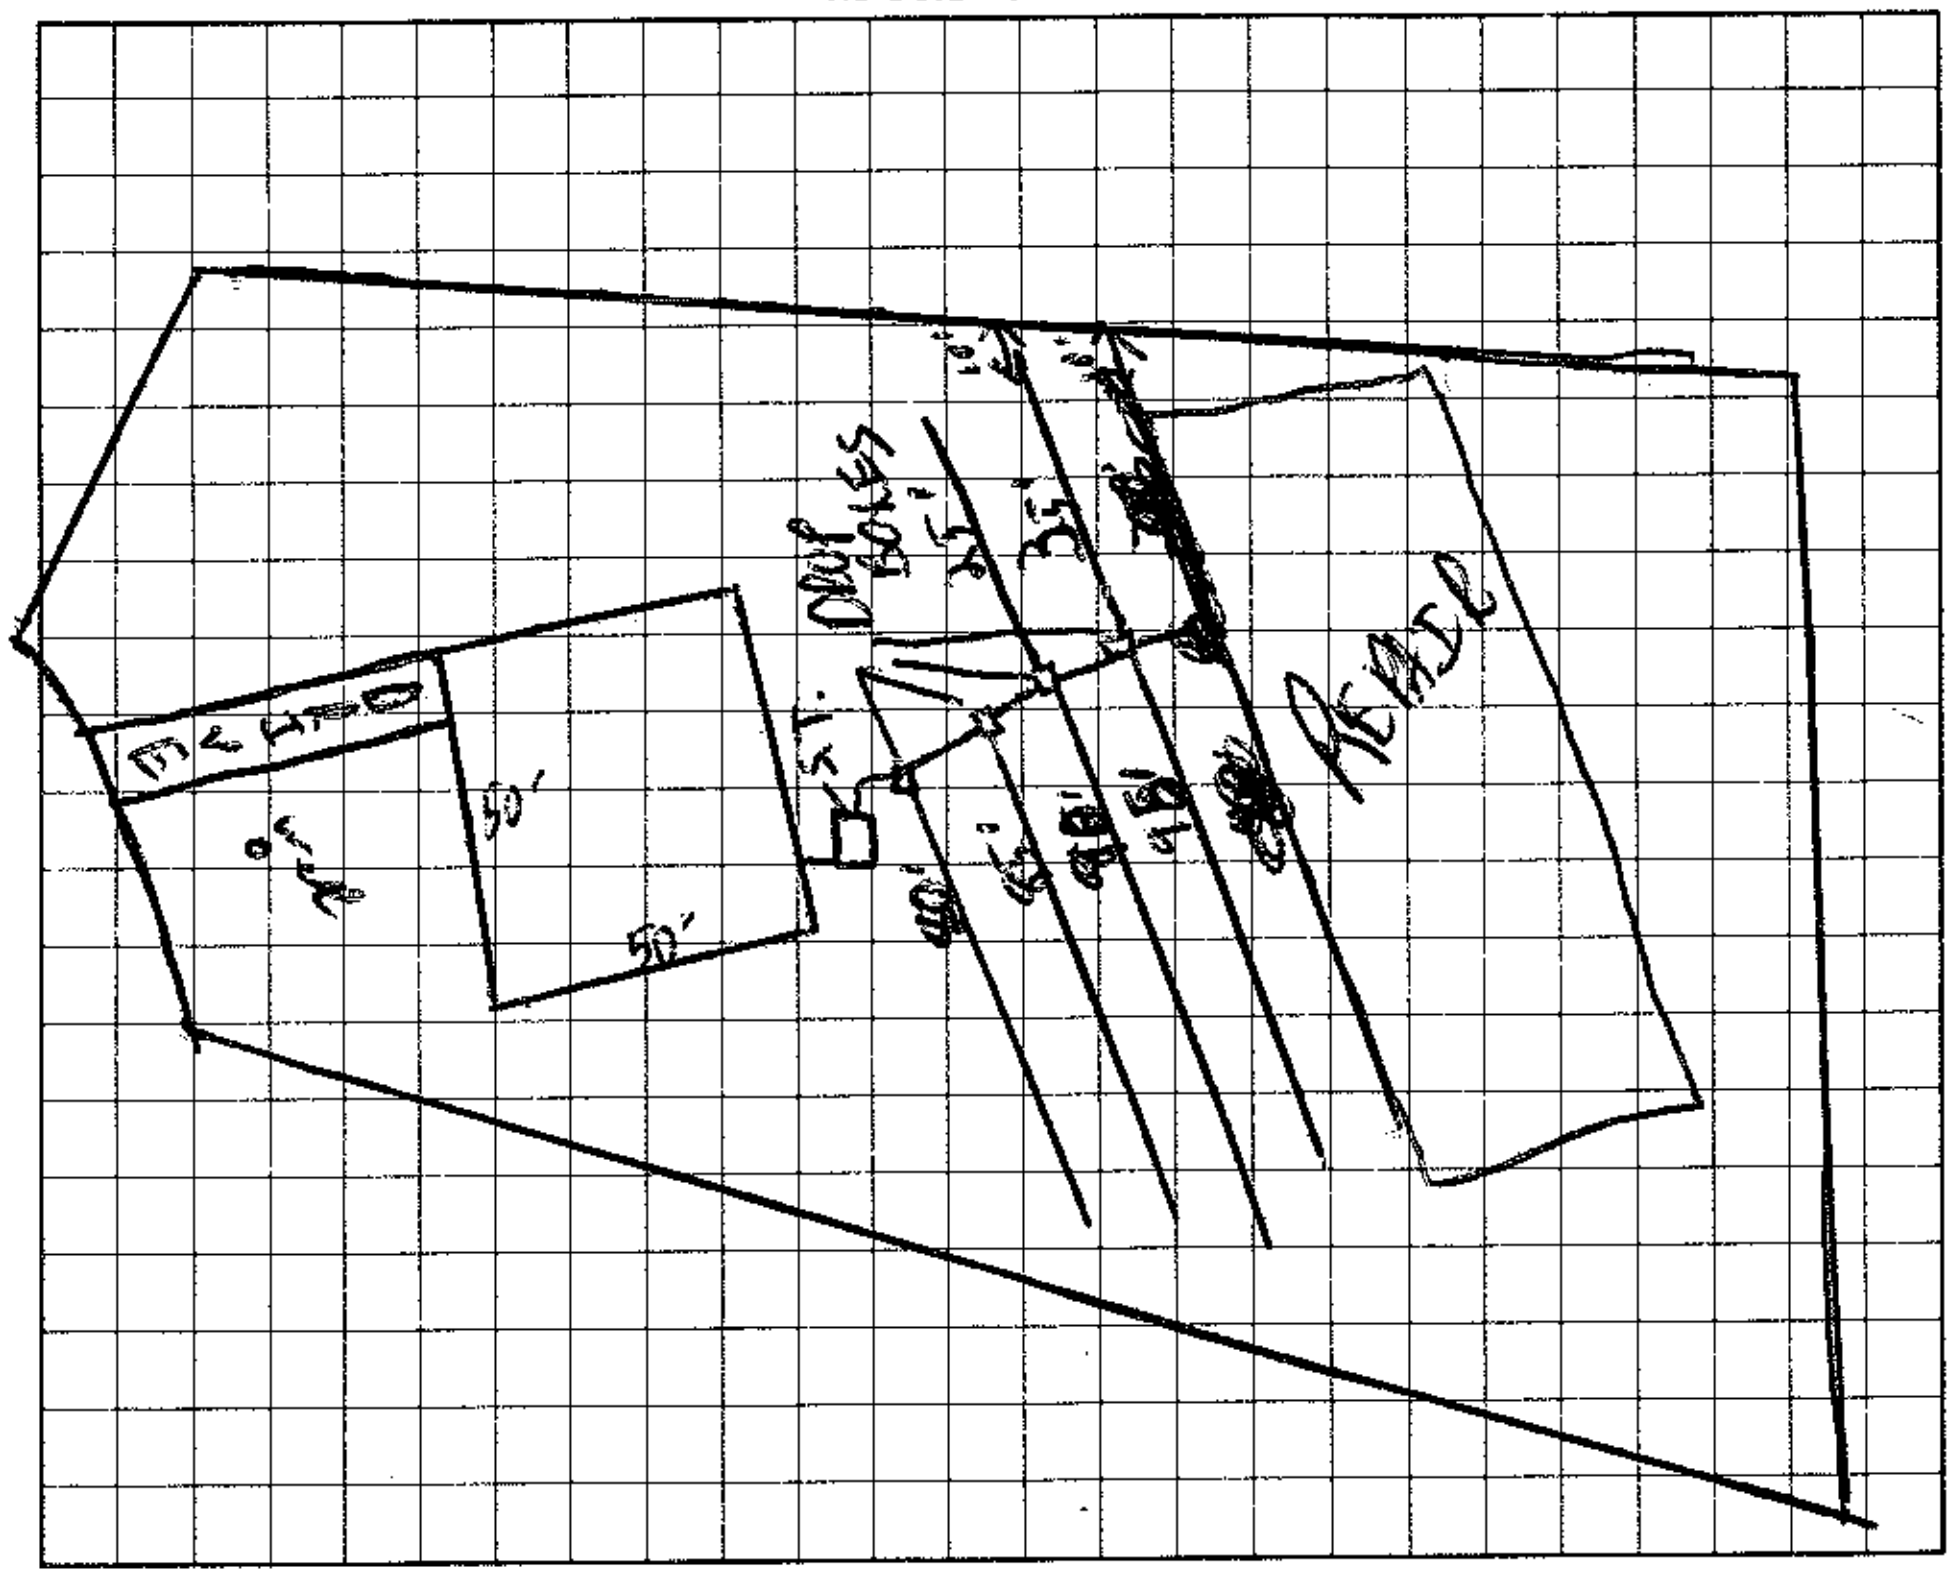

I understand that this permit can be suspended or revoked if any false information is supplied toward securing the permit/any unauthorized changes are made to the site/any unauthorized changes are made in the installation of the system.

Signed:

Improvement Permit by: RS date 12-19-95

Authorization to construct

Existing System Inspection by: RS date Jan 11, '96

Installed by: George Kirkpatrick – Rowan Septic

Certificate of Completion by: date

Operation Permit by: EHSI date 10/4/96

HEALTH DEPT. COPY: WHITE INSPECTION COPY (FINAL): GREEN OWNER COPY (FINAL): YELLOW INSPECTION COPY (INITIAL): PINK OWNER COPY (INITIAL): GOLD