IREDELL COUNTY HEALTH DEPARTMENT

Authorization to Construct 4639-00-6840

STATESVILLE 704-878-5305 MOORESVILLE 704-664-5281

IMPROVEMENT PERMIT / CERTIFICATE OF COMPLETION / OPERATION PERMIT / EXISTING SYSTEM INSPECTION

PROPERTY DESCRIPTION NO. 068194 DATE 8/9/97 TAX MAP NO. 4693900 6840 Watershed: [X] Yes [ ] No

OWNER OR CONTRACTOR Westgate Circle Co. (BOB RICHARDSON) PHONE: Business _____ Home 910-768-7289

ADDRESS PO Box 24533 Winston-Salem, NC 27114

LOCATION North N Fern Hill Rd, TR Riverbend, on (L) next to last lot

SUBDIVISION C L + T BLOCK / SECTION 15 LOT 968 LOT AREA 1.06 SITE CLASS. PS DESIGN FLOW 600 L.T.A.R. .3

Septic Tank: 1250 Gallons; STB _____ Date _____

Pump Tank: 1250 Gallons; PT _____ Date _____

Pump Make: _____ Model _____ Serial No. _____

Nitrification Field: No Fields 1 Square Feet 306 Linear Feet 153

No Lines 3 Trench Width 24" Max Trench Bottom Depth 36" Gravel Depth SAND.

[X] New System [ ] Repair System Type: I, II, III, (IV), V, VI

System Description: Addn - 16" PPBS

Repair System Description: SAME

Maintenance Agreement Required: [X] Yes [ ] No

[X] House/Mod. Home No. Bedrooms 5

[ ] Mobile Home No. Bathrooms 3

[ ] Business No. Employees _____

[ ] Other _____


[ ] Slab [ ] Crawl Space [X] Basement w/plumbing [ ] Basement wo/plumbing

Water Supply: [X] Individual [ ] Community [ ] Public


Comments: Tanks are existing - adding 153 linear feet of 16" PPBS - Type IV distribution 3/16 hole per panel - turn hole up inside each panel (1) (2) (3) NEW LINES

Comments: David Baxter - 10/31/88 Typ IV
7 lines total

INITIAL SITE SKETCH

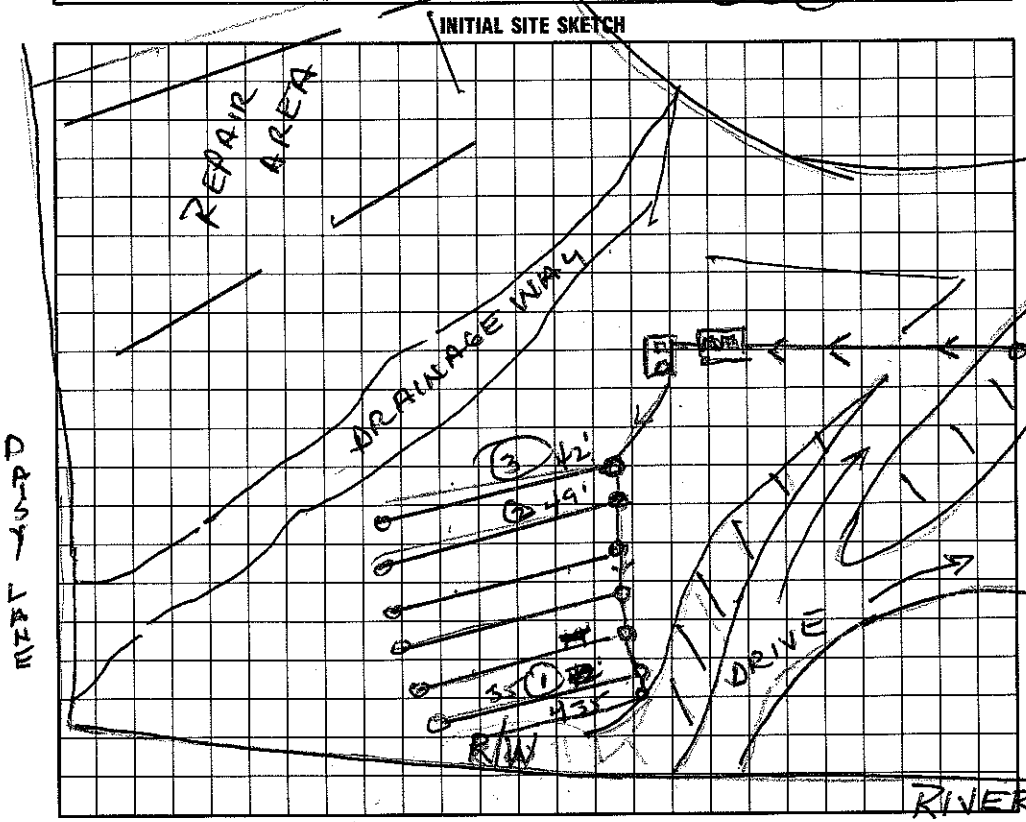

AS BUILT SKETCH

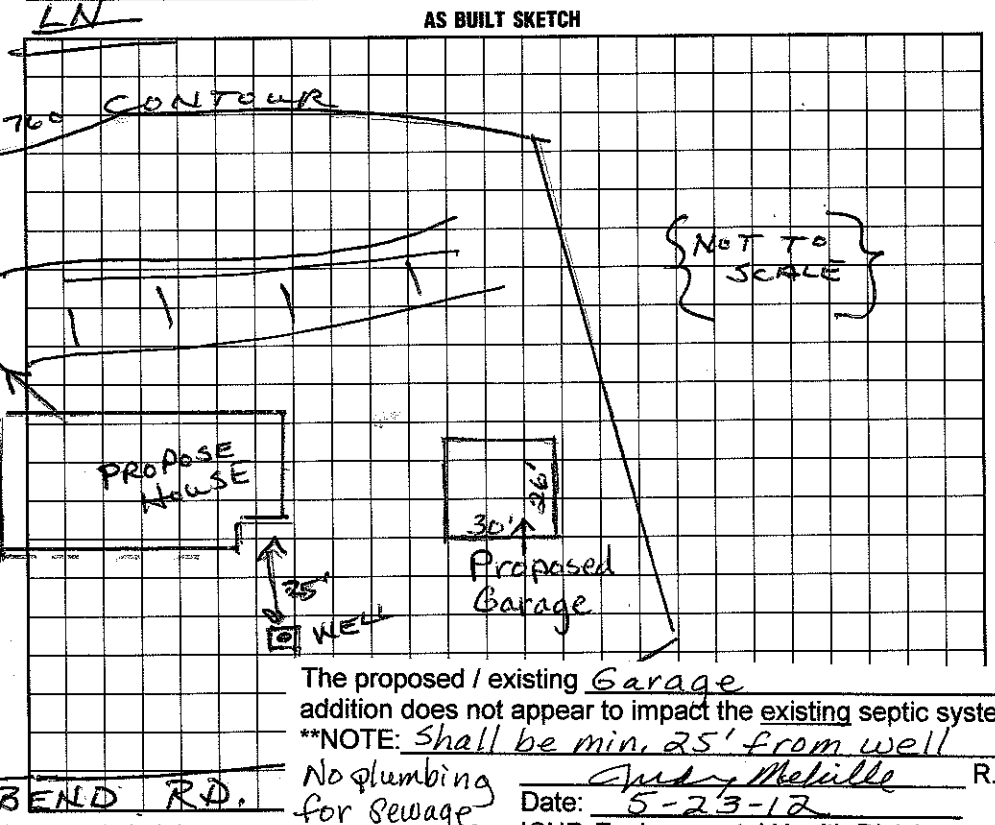

The proposed / existing Garage addition does not appear to impact the existing septic system.

**NOTE: Shall be min. 25' from well

No plumbing for sewage

Judy Melville R.S.

Date: 5-23-12

ICHD-Environmental Health Division

I understand that this permit can be suspended or revoked if any false information is supplied toward securing the permit/any unauthorized changes are n
Improvement Permit is valid for 60 months from date of issuance.

Signed: X R D Richards

Improvement Permit by: Wesley Sparks R.S. date 8/9/97

System Inspection by: Wesley Sparks R.S. date 8/9/97

Installed by: Barry Aginon

Certificate of Completion by: Wesley Sparks R.S. date 7/1/99

Operation Permit by: Wesley Sparks R.S. date 7/1/99

HEALTH DEPT. COPY: WHITE | INSPECTION COPY (FINAL): GREEN | OWNER COPY (FINAL): YELLOW | INSPECTION COPY (INITIAL): PINK | OWNER COPY (INITIAL): GOLD

Daisy Lane