IREDELL COUNTY HEALTH DEPARTMENT

Authorization to Construct 4639-00-6840

STATESVILLE 704-878-5305 MOORESVILLE 704-664-5281

IMPROVEMENT PERMIT / ~~CERTIFICATE OF COMPLETION~~ / OPERATION PERMIT / EXISTING SYSTEM INSPECTIO

PROPERTY DESCRIPTION NO. 068194 DATE 8/9/97 TAX MAP NO. 4693900684O Watershed: [X] Yes [ ] N

OWNER OR CONTRACTOR Westgate Circle Co. (BOB RICHARDSON) PHONE: Business _____ Home 910-768-7289

ADDRESS PO Box 24533 Winston-Salem, NC 27114

LOCATION North N Fern Hill Rd, TR Riverbend, on (L) next to last lot

SUBDIVISION CL+T BLOCK / SECTION 15 LOT 968 LOT AREA 1.06 SITE CLASS. PS DESIGN FLOW 600 L.T.A.R. .3

Septic Tank: 1250 Gallons; STB _____ Date _____

Pump Tank: 1250 Gallons; PT _____ Date _____

Pump Make: _____ Model _____ Serial No. _____

Nitrification Field: No Fields 1 Square Feet 306 Linear Feet 153

No Lines 3 Trench Width 24" Max Trench Bottom Depth 36" Gravel Depth SAND.

[X] New System [ ] Repair System Type: I, II, III, (IV) V, VI

System Description: Add'N - 16" YPBS

Repair System Description: SAME

Maintenance Agreement Required: [X] Yes [ ] No

[X] House/Mod. Home No. Bedrooms 5

[ ] Mobile Home No. Bathrooms 3

[ ] Business No. Employees _____

[ ] Other _____

[ ] Slab [ ] Crawl Space [X] Basement w/plumbing [ ] Basement wo/plumbing


Water Supply [X] Individual [ ] Community [ ] Public

Comments: Tanks are existing - adding 153 linear feet of 16" PPBS - Type IV distribution 3/16 hole per panel - turn hole up inside each panel (1)(2)(3) NEW LINES


Comments: David Baxter - 10/31/88 T4P IV

7 lines total

INITIAL SITE SKETCH

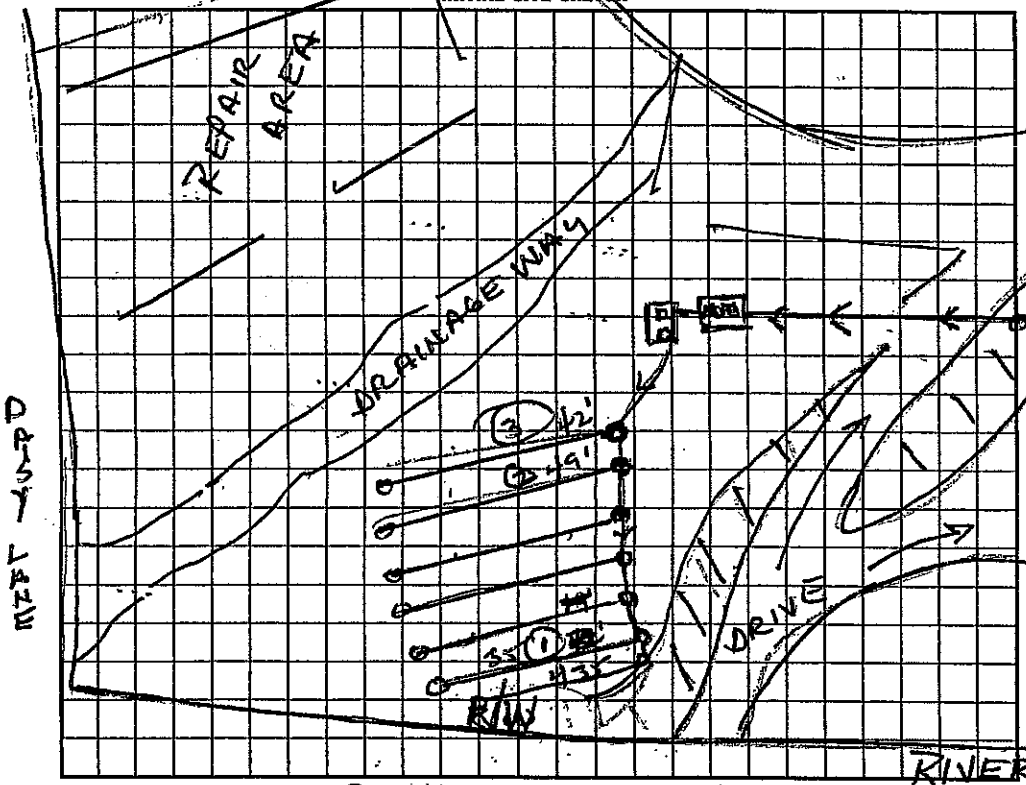

AS BUILT SKETCH

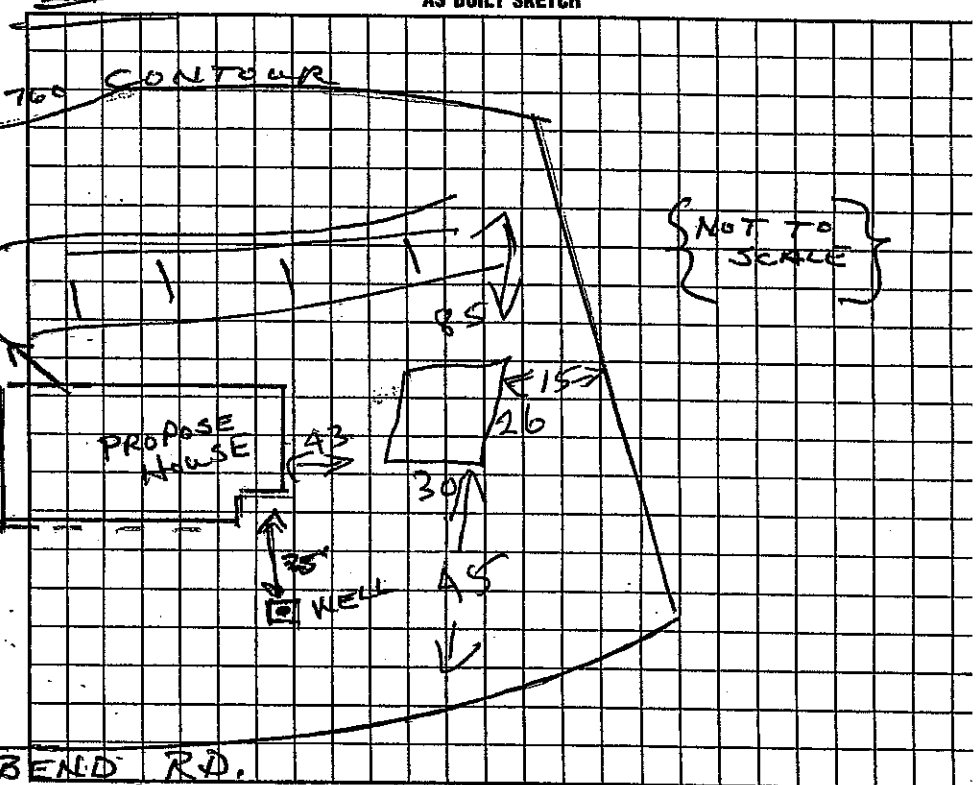

DRY LINE

I understand that this permit can be suspended or revoked if any false information is supplied toward securing the permit/any unauthorized changes are made to the site/any unauthorized changes are made in the installation of the syste Improvement Permit is valid for 60 months from date of Issuance.

Signed: X _____

Improvement Permit by: Wesley Sparks RS. date 8/9/97

Existing System Inspection by: Wesley Sparks RS date 8/9/97

Installed by: Barry Lejmon

Certificate of Completion by: Wesley Sparks RS. date 7/1/99

Operation Permit by: Wesley Sparks RS. date 7/1/99

HEALTH DEPT. COPY: WHITE INSPECTION COPY (FINAL): GREEN OWNER COPY (FINAL): YELLOW INSPECTION COPY (INITIAL): PINK OWNER COPY (INITIAL): GOLD