IREDELL COUNTY HEALTH DEPARTMENT

Statesville Office (704) 878-5305 Mooresville Office (704) 660-3625 PERMIT # 208052

RA

IMPROVEMENT PERMIT / AUTHORIZATION TO CONSTRUCT / OPERATION PERMIT / EXISTING SYSTEM

PIN # 4639-00-9633.000

APPLICANT: TL Strickland Construction APPLICANT ADDRESS: 2245 Kings Rd. Shelby NC

SITE ADDRESS: 117 Onsrud Ln. Mooresville NC PHONE: 704-692-3874 ALT. PHONE: 704-650-7924

SITE DIRECTIONS: Perth to Fern Hill, R on Ringbend, TL on Onsrud. On L

SUBDIVISION: CL&T SECTION: 15 LOT # 166 LOT AREA: DESIGN FLOW: Existing L.T.A.R.: Existing

Septic Tank Existing (gal) STB Date

Pump Tank Existing (gal) PT Date

Pump Make Existing Model Serial #

Nitrification Fields Existing # Lines Existing Linear Ft: Ex.

Trench Width Ex. Max. Trench Bottom Depth Existing Gravel Depth Existing

☐ New System ☐ Repair ☐ Expansion System Type: I II III ☒ IV V VI

System Description: Existing - LPP/PSPS/Conventional

Repair System Description: Existing

Maintenance Agreement Required: ☑ YES ☐ NO

☐ GRAVITY ☒ PRESSURE

☒ Residence No. Bedrooms Ex.

☐ Business No. Persons Ex.

☐ Other No. Employees


☐ Slab ☐ Crawl Space

☒ Basement w/plumbing ☐ Basement w/o plumbing


Water Supply: ☒ Private ☐ Public ☐ Community

Comments / Conditions: Stay at least 5' from Existing Septic System with Proposed Building.

INITIAL SITE SKETCH

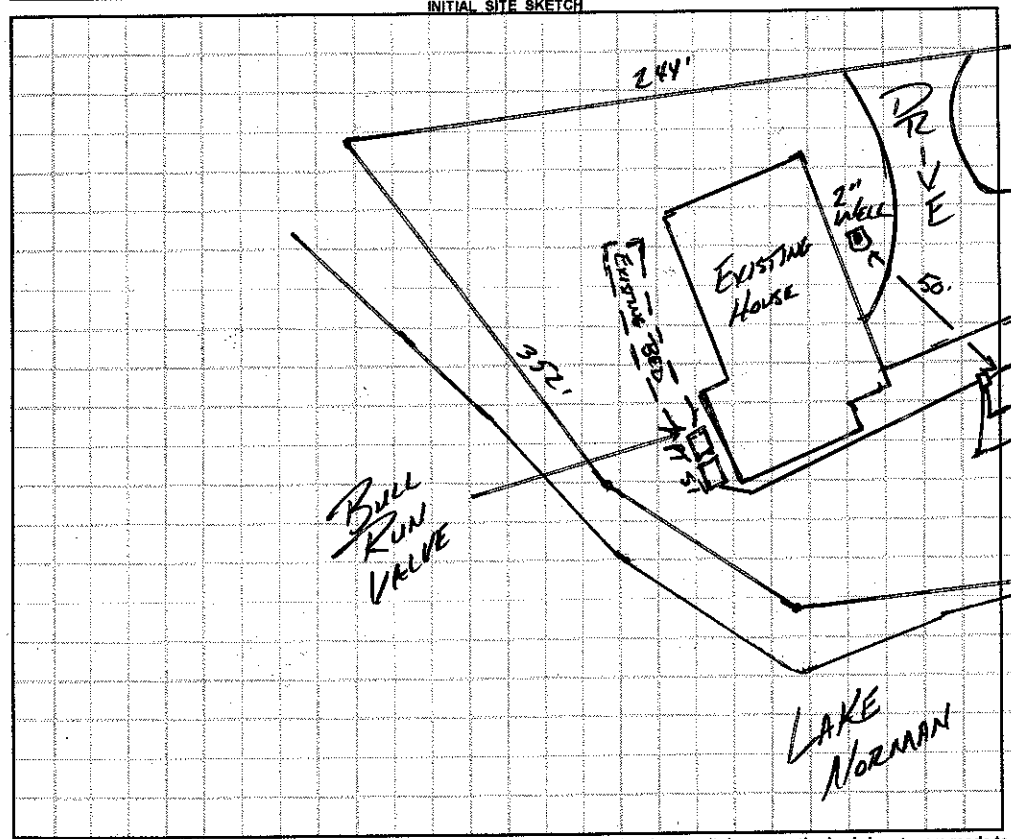

AS BUILT SKETCH

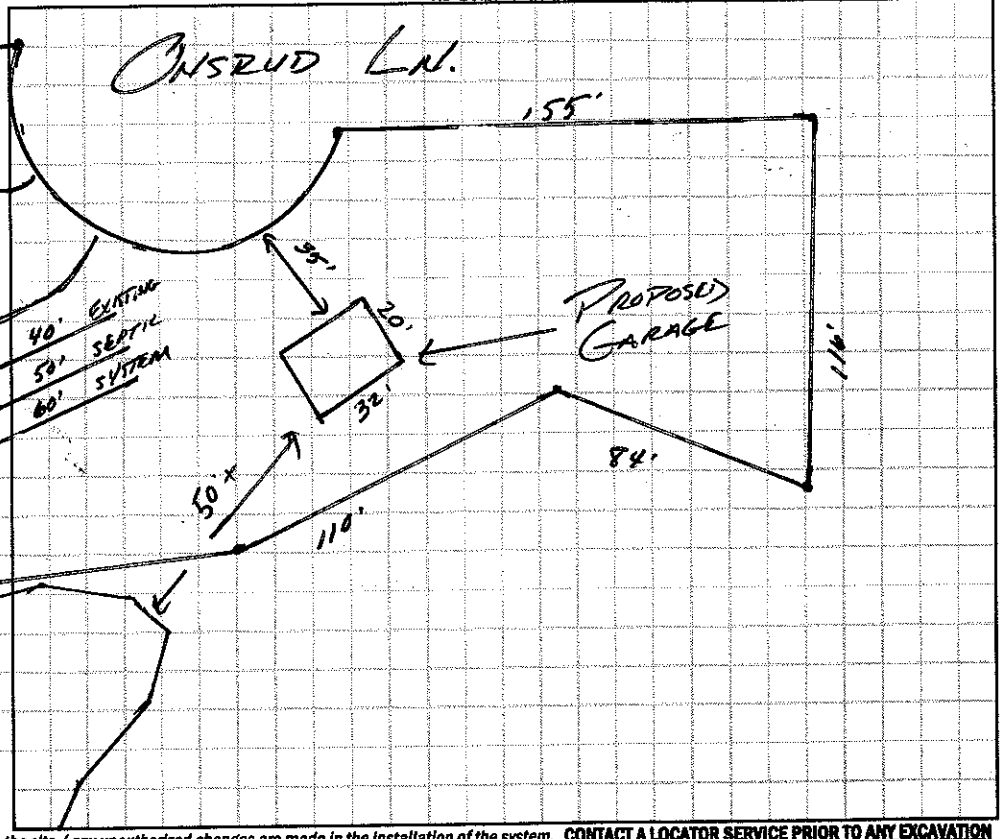

Permit can be suspended or revoked if any false information is supplied toward securing the permit / any unauthorized changes are made to the site / any unauthorized changes are made in the installation of the system. **CONTACT A LOCATOR SERVICE PRIOR TO ANY EXCAVATION**

☐ **IMPROVEMENT PERMIT** *with plat valid without expiration.* ☐ **IMPROVEMENT PERMIT** *with site plan valid for 60 mos.* ☐ **AUTHORIZATION TO CONSTRUCT** *valid for period equal to IMPROVEMENT PERMIT--not to exceed 60 mo.*

Owner / Applicant Signature: M Strickland Date: 5/29/15 Installed by:

IMPROVEMENT PERMIT by: Date: OPERATION PERMIT by: Date:

AUTHORIZATION TO CONSTRUCT by: Date: Existing System Inspected by: APPROVED Date: MAY 08 2015

Health Dept. Copy - WHITE Applicant (Final Approval) - YELLOW Applicant (Conditional Approval) - PINK