IREDELL COUNTY HEALTH DEPARTMENT

STATESVILLE 704-878-5305 MOORESVILLE 704-664-5281

IMPROVEMENT PERMIT / CERTIFICATE OF COMPLETION / OPERATION PERMIT / EXISTING SYSTEM INSPECTION

PROPERTY DESCRIPTION NO. 25911 DATE 1/15/97 TAX MAP NO. 3L-10-A-184 (4639012423) Watershed: ☑ Yes ☐ No

OWNER OR CONTRACTOR PAGE LEMON PHONE: Business _____ Home 663-7423

ADDRESS 1179 MT ULLA HWY. MOORESVILLE NC 28115

LOCATION PERTH RD - TL FERN HILL TOWARD LAKE - TR RIVERBEND ; TR CHESHIRE - AT VERY END CUL-DE-SAC

SUBDIVISION SEC 15 BLOCK / SECTION _____ LOT 184 LOT AREA — SITE CLASS. P3 DESIGN FLOW 240 L.T.A.R. —

Septic Tank: _____ Gallons; STB _____ Date _____

Pump Tank: _____ Gallons; PT _____ Date _____

Pump Make: _____ Model EXISTING Serial No. _____

Nitrification Field: No Fields ____ Square Feet _____ Linear Feet _____

No Lines _____ Trench Width _____ Max Trench Bottom Depth _____ Gravel Depth _____

☐ New System ☐ Repair System Type: I, II, III, IV, V, VI

System Description: GRAVITY CONVENTIONAL

Repair System Description: _____

Maintenance Agreement Required: ☐ Yes ☐ No

☑ House/Mod. Home No. Bedrooms 3

☐ Mobile Home No. Bathrooms 2

☐ Business No. Employees ____

☐ Other _____


☐ Slab ☐ Crawl Space ☐ Basement w/plumbing ☐ Basement wo/plumbing

Water Supply:
☑ Individual
☐ Community
☐ Public

Comments:

Comments:

INITIAL SITE SKETCH

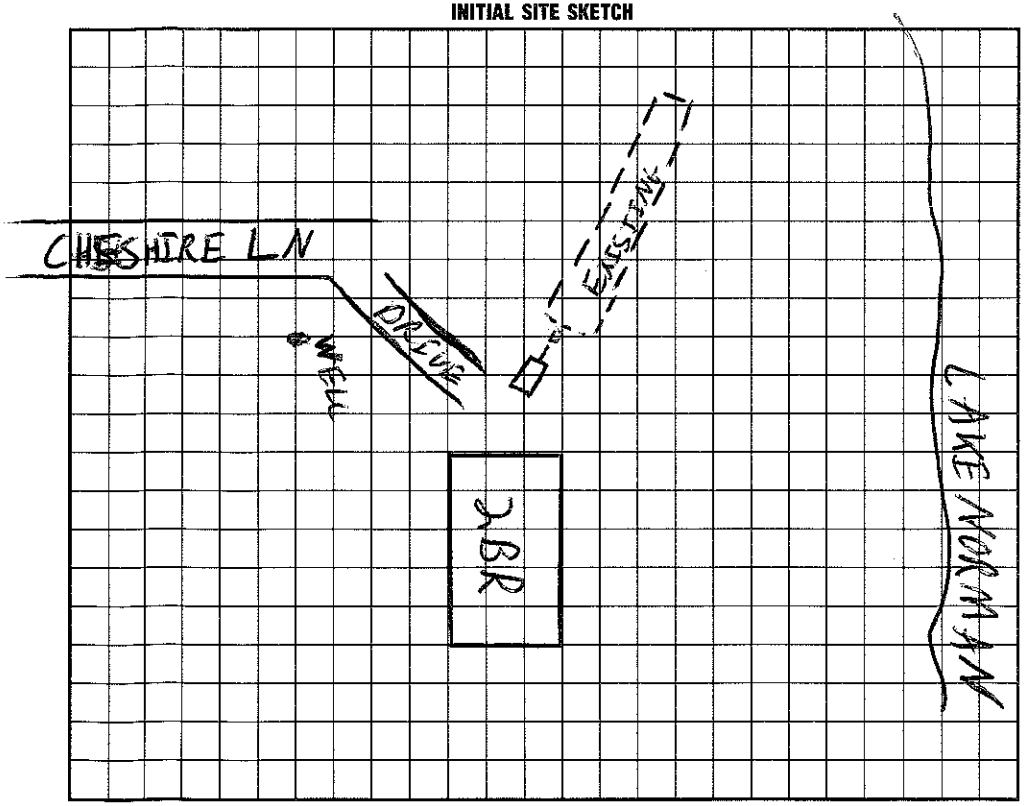

AS BUILT SKETCH

I understand that this permit can be suspended or revoked if any false information is supplied toward securing the permit/any unauthorized changes are made to the site/any unauthorized changes are made in the installation of the system. Improvement Permit is valid for 60 months from date of issuance.

Signed: _____

Installed by: _____

Improvement Permit by: _____ date _____

Certificate of Completion by: _____ date _____

Existing System Inspection by: C. Ray Thomas EHSI date 1/15/97

Operation Permit by: C. Ray Thomas EHSI date 1/15/97

HEALTH DEPT. COPY: WHITE INSPECTION COPY (FINAL): GREEN OWNER COPY (FINAL): YELLOW INSPECTION COPY (INITIAL): PINK OWNER COPY (INITIAL): GOLD