IREDELL COUNTY HEALTH DEPARTMENT

STATESVILLE 704-878-5305 MOORESVILLE 704-664-5281

IMPROVEMENT PERMIT / AUTHORIZATION TO CONSTRUCT / OPERATION PERMIT / EXISTING SYSTEM INSPECTION

PERMIT# 142440 PIN# 4639 02 4963 DATE 6/15/09

OWNER OR APPLICANT ~~Carl A Church~~ Spivey Construct PHONE: Business 828-308-4840 Home 704-489-1841

ADDRESS 7076 Hidden Harbor Ln. Sparrows Point, NC. 28673

LOCATION 282 Bullpen Rd.

SUBDIVISION Beacon Point BLOCK / SECTION 1 LOT 16-16A AREA ~1.2AC SITE CLASS. PS DESIGN FLOW 480 L.T.A.R. .3

Septic Tank: 1000 Gallons; STB 760 Date 11-15-10
Pump Tank: 1000 Gallons; PT 363 Date 11-19-10
Pump Make: Myers Model ME45 Serial No.
Nitrification Field: No Fields 1 Square Feet 840 Linear Feet
No Lines 7@40 Trench Width 2-3' Max Trench Bottom Depth 3'

☒ New System ☐ Repair ☐ Expansion System Type: I II III (IV) V VI
System Description: LD - 16" PPBPS
Repair System Description: OFFSITE ESMT L 16A
Maintenance Agreement Required: ☒ Yes ☐ No

☒ House/Mod. Home No. Bedrooms 4
☐ Mobile Home No. Persons
☐ Business No. Employees
☐ Other

Water Supply: ☐ Individual ☐ Public ☒ Community


Gravel Depth No ☐ Gravity ☐ Pressure ☐ Slab ☒ Crawl Space ☐ Basement w/plumbing ☐ Basement wo/plumbing

Comments/Conditions: 50% Reduced System (PPBPS) LVN
Repair Area 16A - OFFSITE BEYOND
PARKING AREA
Home plans required before AC.


Comments/Conditions: 12/9/10 Reviewed Site plans & Floor plans, in Compliance with original permit.

1" = 40'

INITIAL SITE SKETCH

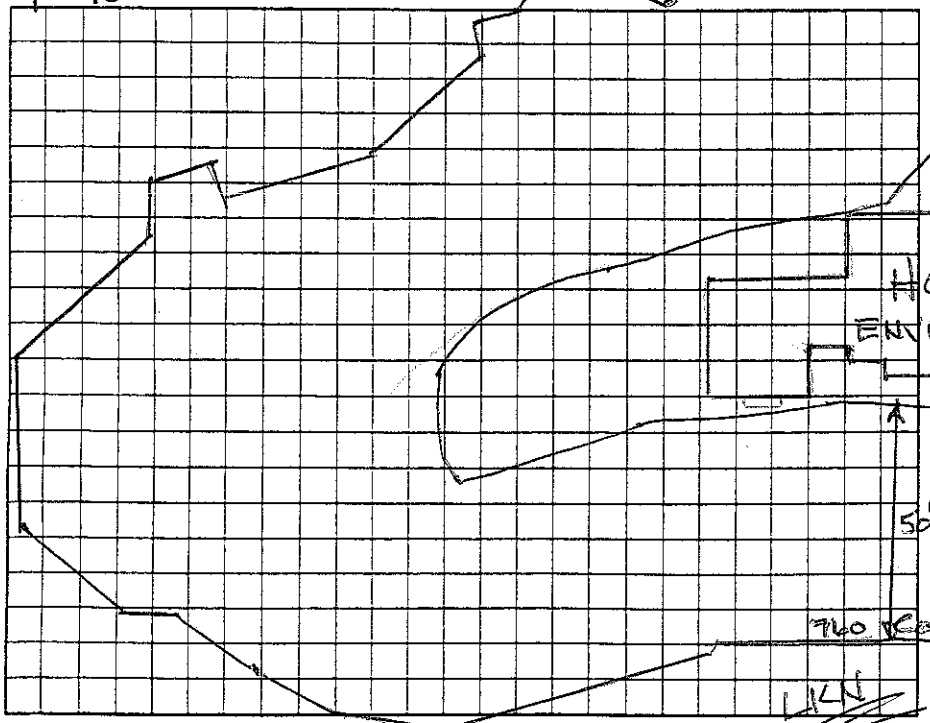

AS BUILT SKETCH

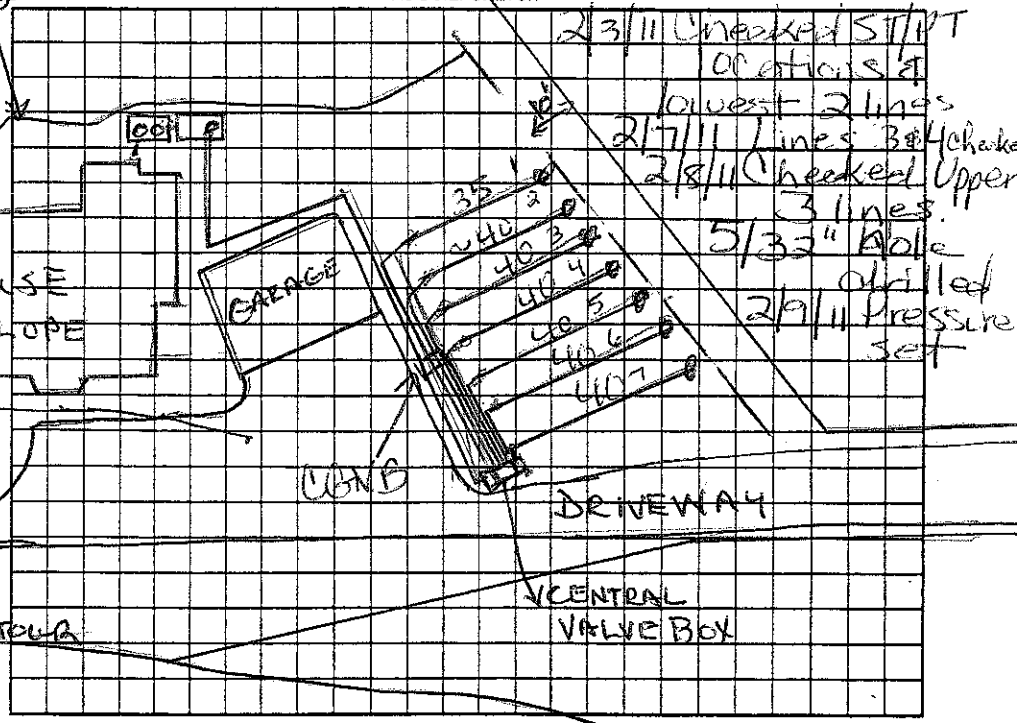

2/7/11 Lines 3 & 4 checked
2/8/11 Checked Upper 3 lines.
5/32" Hole drilled
2/9/11 Pressure set

Permit can be suspended or revoked if any false information is supplied toward securing the permit/any unauthorized changes are made to the site/any unauthorized changes are made in the installation of the system. Improvement Permit with plat valid without expiration ☒ Improvement Permit with site plan valid for sixty months ☐ Authorization to Construct is valid for a period equal to that of Improvement Permit – not to exceed sixty months.

Signed: ✕ Mickey Lanyon date

Improvement Permit by: Wesley Spurlock R.S. date 6/18/09

Authorization to Construct by: Marcus H. Coleman R.S. date 12/9/10

Installed by: Specialty Septic

Operation Permit by: Marcus H. Coleman date 12/1/11

Existing System Inspection by: date

HEALTH DEPT. COPY: WHITE OWNER COPY (FINAL): YELLOW OWNER COPY (INITIAL): PINK