IREDELL COUNTY HEALTH DEPARTMENT

STATESVILLE 704-878-5305 4639028410 MOORESVILLE 704-664-5281

IMPROVEMENT PERMIT / CERTIFICATE OF COMPLETION / OPERATION PERMIT / EXISTING SYSTEM INSPECTION

PROPERTY DESCRIPTION NO. 19173 DATE 7/14/94 TAX MAP NO. 3C-10-A-198 Watershed: ☐ Yes ☑ No

OWNER OR CONTRACTOR R. PATRICK HAUSER (BOB SCHURMEIER) PHONE: Business _____ Home 528-1989

ADDRESS PO BOX 1053 TROUTMAN, NC. 28166

LOCATION END OF CARLTON RD.

SUBDIVISION CLT BLOCK / SECTION 15 LOT 198 LOT AREA ~.75 SITE CLASS. P DESIGN FLOW 360 L.T.A.R. _____

Septic Tank: Existing Gallons; STB _____ Date _____

Pump Tank: _____ Gallons; PT _____ Date _____

Pump Make: _____ Model _____ Serial No. _____

Nitrification Field: No Fields ____ Square Feet _____ Linear Feet _____

No Lines Existing Trench Width _____ Max Trench Bottom Depth _____ Gravel Depth _____

☐ New System ☐ Repair System Type: ☐ I ☐ II, IV, V, VI

System Description: Existing

Repair System Description: _____

Maintenance Agreement Required: ☐ Yes ☑ No

☑ House/Mod. Home No. Bedrooms 3 (4)

☐ Mobile Home No. Bathrooms 1½

☐ Business No. Employees ____

☐ Other _____

☐ Slab ☐ Crawl Space ☑ Basement w/plumbing ☐ Basement wo/plumbing


Water Supply:
☑ Individual
☐ Community
☐ Public
ON SITE

Comments:

See Permit 77 - Pat Hauser
80 - Pat Hauser

Comments:

~~MINIMUM SITE SKETCH~~ AS BUILT SKETCH

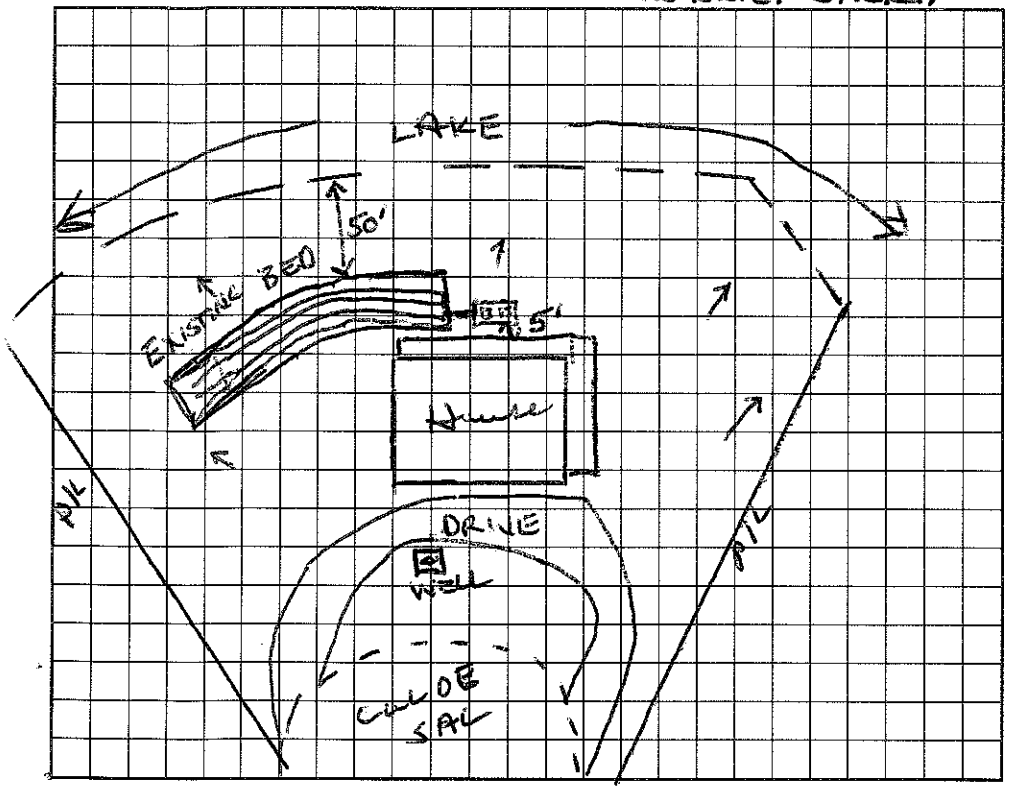

AS BUILT SKETCH

I understand that this permit can be suspended or revoked if any false information is supplied toward securing the permit/any unauthorized changes are made to the site/any unauthorized changes are made in the installation of the system. Improvement Permit is valid for 60 months from date of issuance.

Signed: _____

Improvement Permit by: _____ date _____

Existing System Inspection by: Wesley Sparks RS. date 7/14/94

Installed by: _____

Certificate of Completion by: _____ date _____

Operation Permit by: _____ date _____

HEALTH DEPT. COPY: WHITE INSPECTION COPY (FINAL): GREEN OWNER COPY (FINAL): YELLOW INSPECTION COPY (INITIAL): PINK OWNER COPY (INITIAL): GOLD