IREDELL COUNTY HEALTH DEPARTMENT

STATESVILLE 704-878-5305 MOORESVILLE 704-664-5281

IMPROVEMENT PERMIT / CERTIFICATE OF COMPLETION / OPERATION PERMIT / EXISTING SYSTEM INSPECTION

PROPERTY DESCRIPTION NO. 16871 DATE April 23, '96 TAX MAP NO. part of 25A51 4639-03-6275 Watershed: ☑ Yes ☐ No

OWNER OR CONTRACTOR Randy Meredith PHONE: Business _____ Home 528-3319

ADDRESS _____

LOCATION Fern Hill Road TR Bullfinch at end on Right

SUBDIVISION Beacon Pointe BLOCK / SECTION 1 LOT 14 LOT AREA ~.6 Ac SITE CLASS 5 Spec. 1956 DESIGN FLOW 480 gpd L.T.A.R. ~.25

Septic Tank: 1000 Gallons; STB 714 Date _____

Pump Tank: 1000 Gallons; PT 27 Date 5/30/96

Pump Make: _____ Model _____ Serial No. 8/27/96

Nitrification Field: No Fields 2 Square Feet 640 Linear Feet 320

No Lines 4+3 Trench Width 24" Max Trench Bottom Depth ~ 28" Gravel Depth NA

☐ New System ☐ Repair System Type: I, II, III, IV, V, VI

System Description: LPP BBBS

Repair System Description: LPP - off site easement

Maintenance Agreement Required: ☑ Yes ☐ No

☑ House/Mod. Home No. Bedrooms 4

☐ Mobile Home No. Bathrooms 4

☐ Business No. Employees ____

☐ Other _____

☐ Slab ☑ Crawl Space ☐ Basement w/plumbing ☐ Basement wo/plumbing

Water Supply: ☐ Individual ☑ Community ☐ Public


Comments:

Comments: Pre-construction conference required w/ system installer!

250 gal dose – 5 minute cycle – 74 panels total – one 3/16 hole/panel


37 panels per field 2' pressure head field A, 3' pressure head field B

INITIAL SITE SKETCH

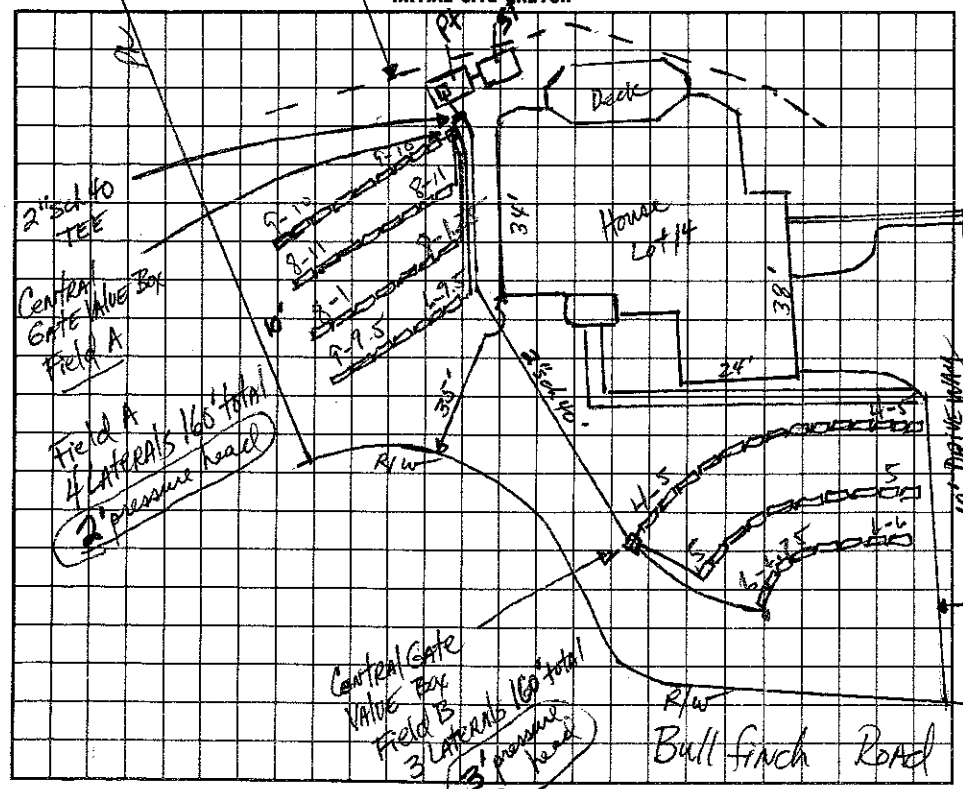

1" = 40'

AS BUILT SKETCH

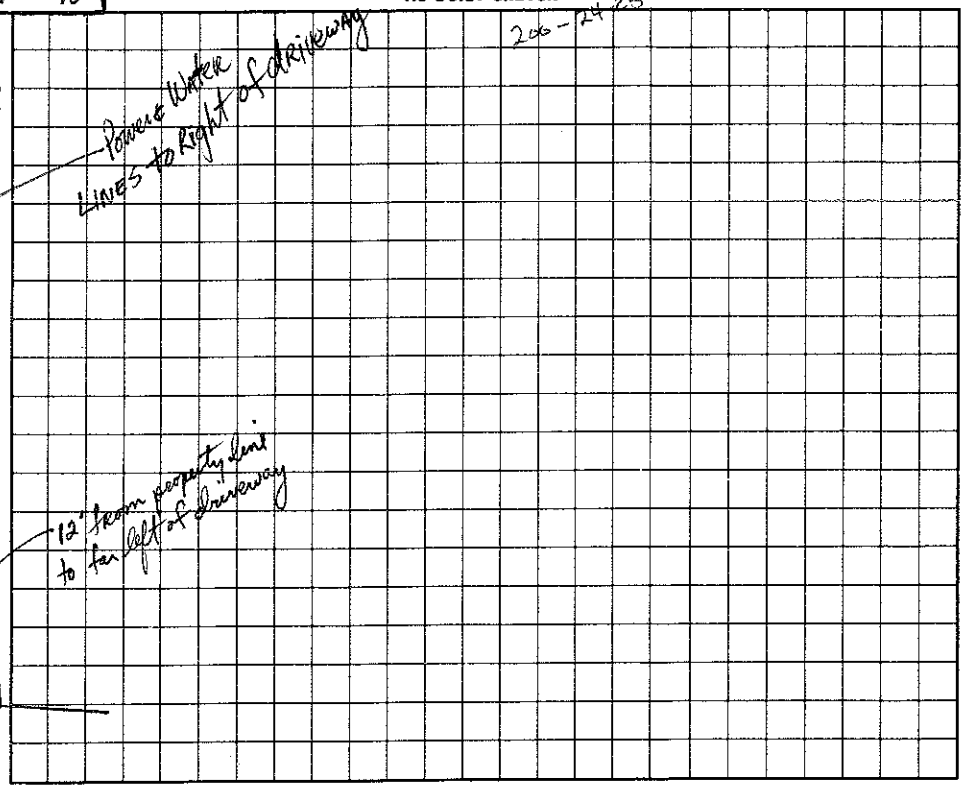

I understand that this permit can be suspended or revoked if any false information is supplied toward securing the permit/any unauthorized changes are made to the site/any unauthorized changes are made in the installation of the system.

Signed: Randy Meredith

Improvement Permit by: _____ date 4-23-96

~~Existing System Inspection by:~~ Construction Authorization _____ date 4-23-96

Installed by: Macleod Const.

Certificate of Completion by: _____ date _____

Operation Permit by: _____ date 12-11-96

HEALTH DEPT. COPY: WHITE INSPECTION COPY (FINAL): GREEN OWNER COPY (FINAL): YELLOW INSPECTION COPY (INITIAL): PINK OWNER COPY (INITIAL): GOLD