IREDELL COUNTY HEALTH DEPARTMENT

STATESVILLE 704-878-5305 MOORESVILLE 704-664-5281

IMPROVEMENT PERMIT / CERTIFICATE OF COMPLETION / OPERATION PERMIT / EXISTING SYSTEM INSPECTION

PROPERTY DESCRIPTION NO. 18867 DATE Oct. 2, 195 TAX MAP NO. part of 25A51 4639039648 Watershed: ☐ Yes ☐ No

OWNER OR CONTRACTOR Ron Whicker PHONE: Business _____ Home _____

ADDRESS _____

LOCATION From Hill Rd. TR Bullfinch on Right

SUBDIVISION Beacon Pointe BLOCK / SECTION _____ LOT 10 LOT AREA 7 20,000 ft² SITE CLASS. 1948 D 1956 DESIGN FLOW 480 gpd L.T.A.R. .4 (542 sqft)

Septic Tank: 1000 Gallons; STB TP 10 12 Date 8-15-95

Pump Tank: 1000 Gallons; PT TP 17 Date 9-21-95

Pump Make: Crulls Model _____ Serial No. H 255760

Nitrification Field: No Fields 1 Square Feet 900 Linear Feet 300

No Lines 4 @ 75' Trench Width 36" Trench Bottom Depth 5' Gravel Depth 3' SAND

☑ New System ☐ Repair System Type: I, II, III, IV, V, VI

System Description: Sand Lined Infiltrator

Repair System Description: Same

Maintenance Agreement Required: ☐ Yes ☑ No

☑ House/Mod. Home No. Bedrooms 4

☐ Mobile Home No. Bathrooms 4

☐ Business No. Employees _____

☐ Other _____

☐ Slab ☐ Crawl Space ☑ Basement w/plumbing ☐ Basement wo/plumbing


Water Supply: ☐ Individual ☑ Community ☐ Public

Comments: Saprolite evaluation revealed usable SL SAP at 4½-5', use of 3' of sand with 5' deep trenches allow utilization of this zone.


Comments: 10/27/95 System installed & closed.

1" = 50'

INITIAL SITE SKETCH

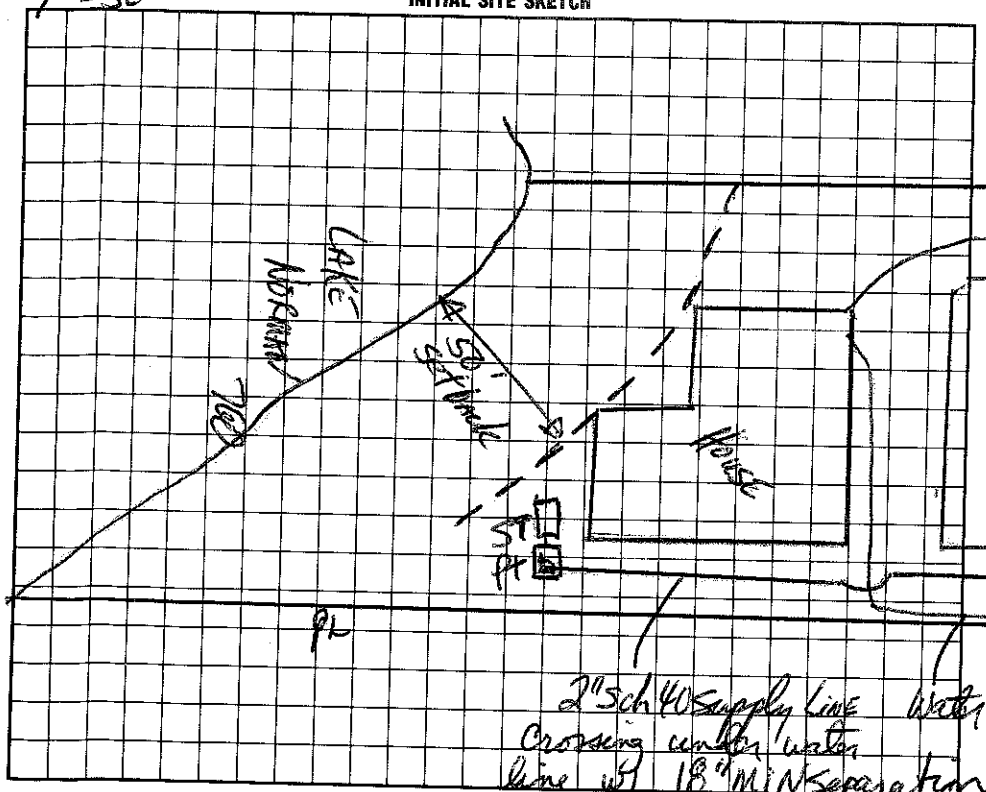

AS BUILT SKETCH

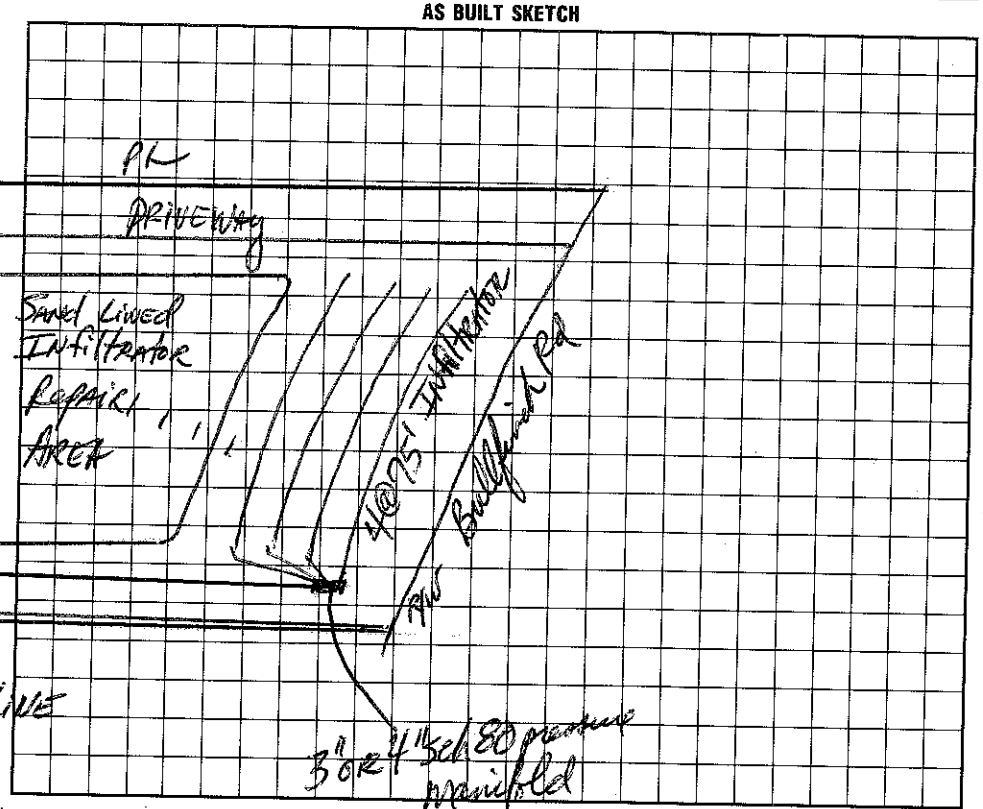

I understand that this permit can be suspended or revoked if any false information is supplied toward securing the permit/any unauthorized changes are made to the site/any unauthorized changes are made in the installation of the system.

Signed: Ron W Whicker

Improvement Permit by: [signature] IRS date 10/2/95

Existing System Inspection by: [signature] IRS date 10/2/95

Installed by: Kenny Pearson

Certificate of Completion by: _____ date _____

Operation Permit by: [signature] IRS date 1-22-96

HEALTH DEPT. COPY: WHITE INSPECTION COPY (FINAL): GREEN OWNER COPY (FINAL): YELLOW INSPECTION COPY (INITIAL): PINK OWNER COPY (INITIAL): GOLD