IREDELL COUNTY HEALTH DEPARTMENT

STATESVILLE 704-878-5305 MOORESVILLE 704-664-5281

IMPROVEMENT PERMIT / AUTHORIZATION TO CONSTRUCT / OPERATION PERMIT / EXISTING SYSTEM INSPECTION

PERMIT # 164203 PIN # 4639039648 DATE 12-8-2010

OWNER or APPLICANT Harkness Builders/Bruce Dunn PHONE: Business Larry 7047997744 Home:

OWNER or APPLICANT ADDRESS 242 Templeton Rd Mooresville NC 28117

LOCATION / DIRECTIONS Perth Rd N TL Fern Hill TR Bullfinch on Right #244

SUBDIVISION Beacon Pt. BLOCK / SECTION 1 LOT # 10 LOT AREA .82Ac DESIGN FLOW 480gpd L.T.A.R. .4

Exist.

Septic Tank 1000 Gallons: STB Date

Pump Tank 1000 Gallons: P T Date

Pump Make Model Serial #

Nitrification Field No Fields 1 No Lines 4 Linear Feet 300

Trench Width 36" Max. Trench Bottom Depth 5ft. Gravel Depth 3ft

☐ New System ☐ Repair ☐ Expansion System Type I II III IV V VI

System Description: Exist. Pump-PM-Sgae lined 35% Reduct.

Repair System Description: Same

Maintenance Agreement Required ☐ YES ☒ NO

☐ GRAVITY ☒ PRESSURE


☒ Residence No. Bedrooms 4 ☐ Business No. Persons ☐ Other No. Employees ☐ Slab ☐ Crawl Space ☒ Basement w/plumbing ☐ Basement w/o plumbing

Water Supply: ☐ Private ☒ Public ☐ Community


Comments / Conditions: Must keep any Building at least 5ft from Septic System including (Repair Areas) Scale 1:40

Comments / Conditions: Existing Septic System appears to be functioning okay at time of inspection.

INITIAL SITE SKETCH

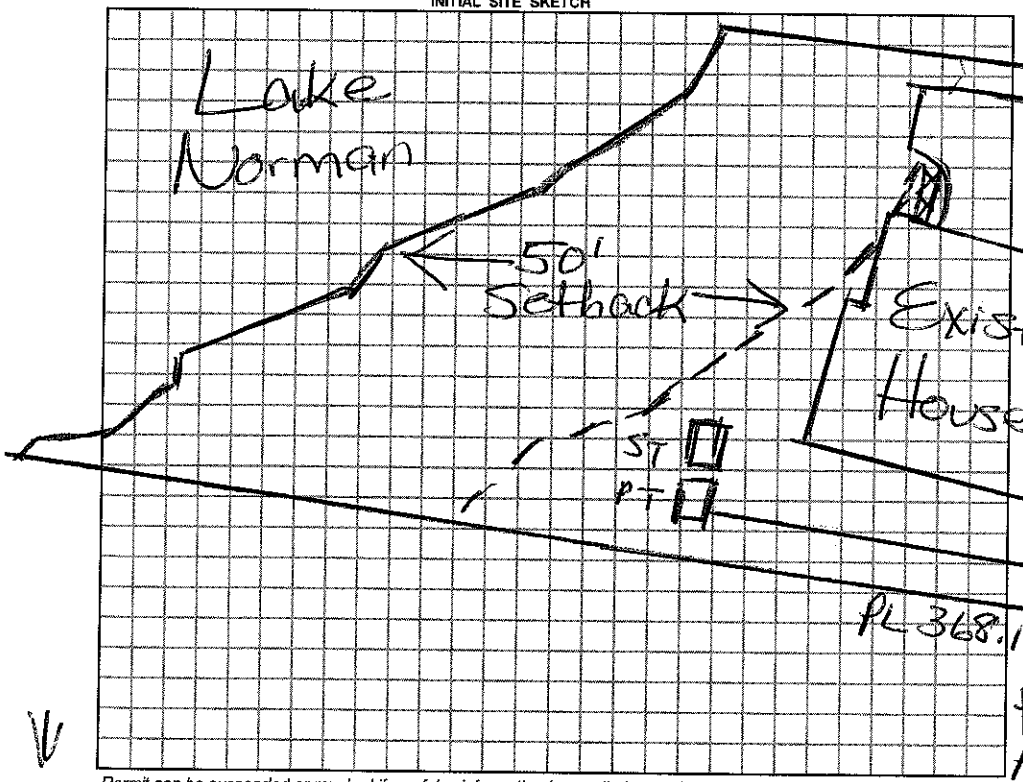

AS BUILT SKETCH

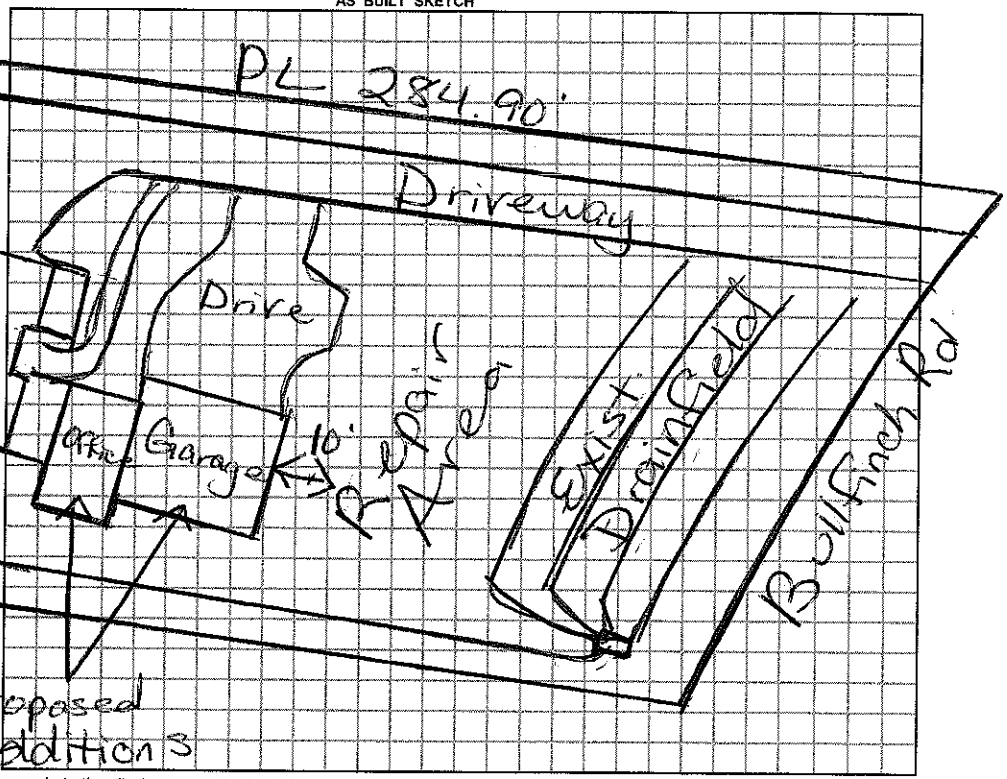

N

Permit can be suspended or revoked if any false information is supplied toward securing the permit / any unauthorized changes are made to the site / any unauthorized changes are made in the installation of the system.

☐ *IMPROVEMENT PERMIT w / plat valid without expiration.* ☐ *IMPROVEMENT PERMIT w / site plan valid for 60 mos.* ☐ *AUTHORIZATION TO CONSTRUCT valid for period equal to IMPROVEMENT PERMIT-not to exceed 60 mo.*

Owner / Applicant Signature: [signature] Date 12/8/10

Improvement Permit by: Date

Authorization to Construct by: Date

Installed by:

Operation Permit by: Date:

Existing System Inspected by: [signature] RS Date: 12/8/2010

YOU SHOULD CONTACT A LOCATOR SERVICE PRIOR TO ANY EXCAVATION.

WHITE COPY Environmental Health YELLOW COPY (Final) Owner / Applicant PINK COPY (Initial) Owner / Applicant