IREDELL COUNTY HEALTH DEPARTMENT

Statesville Phone TR 3-7271 — Mooresville Phone NO 3-1271

PERMIT TO INSTALL SEPTIC TANK

Permit No. 224 — Permit Date April 8 1971

Owner F. M. Harrington — Address Statesville, NC

Installed By Sam Ostwalt — Address Troutman, N C

Location of Property


SECTION [redacted] 18 Lot 11

Tank		Capacity		Length of Lines		Fixtures	
Block	( )	1000	(✓)	225'	(✓)	No. of Baths	(1)
Precast	(✓)	1250	( )	250'	( )	Dishwasher	( )
		1500	( )	Other		Garbage Grdr.	( )
		Other		1½" Gravel		Other	

NOTIFY HEALTH DEPARTMENT AT LEAST EIGHT HOURS BEFORE TANK IS TO BE INSPECTED.

Final Inspection April 8 1971 — Approved (✓) Disapproved ( )

Remarks

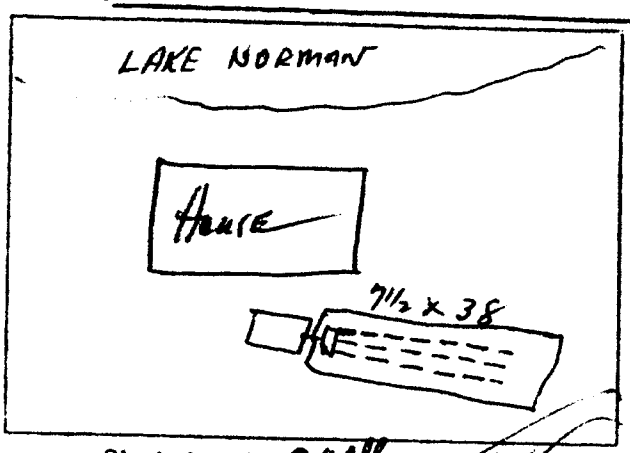

Sketch of Installation

Glenn Fox
Sanitarian