IREDELL COUNTY HEALTH DEPARTMENT

STATESVILLE 704-878-5305 MOORESVILLE 704-664-5281

IMPROVEMENT PERMIT / CERTIFICATE OF COMPLETION / OPERATION PERMIT / EXISTING SYSTEM INSPECTION

PROPERTY DESCRIPTION NO. Repair DATE 11-29-93 TAX MAP NO. Repair Watershed: ☐ Yes ☑ No

OWNER OR CONTRACTOR Douglas G. Eisele PHONE: Business Home 528-4733

ADDRESS Rt. 2 Box 248L Troutman, N.C. 28166

LOCATION From Troutman take Perth Rd. TR state Park TL Morrison Farm Rd. TL Stillwater. Lot 3/3 mile on L.

SUBDIVISION — BLOCK / SECTION — LOT — LOT AREA ≈ .8 acre SITE CLASS. Existing DESIGN FLOW 600 L.T.A.R. Existing

Septic Tank: Existing Gallons; STB — Date —

Pump Tank: — Gallons; PT — Date —

Pump Make: — Model — Serial No. —

Nitrification Field: No Fields 2 Square Feet 660 Linear Feet 340'

No Lines 2 Trench Width 7' and 36" Max Trench Bottom Depth 36" Gravel Depth 16"

☐ New System ☑ Repair System Type: I, II, III, IV, V, VI

System Description: Conventional, gravity

Repair System Description: Pump to conventional

Maintenance Agreement Required: ☐ Yes ☑ No

☑ House/Mod. Home ☐ Mobile Home ☐ Business ☐ Other


No. Bedrooms 5 No. Bathrooms 3 No. Employees —

☐ Slab ☑ Crawl Space ☐ Basement w/plumbing ☐ Basement wo/plumbing

Water Supply: ☑ Individual ☐ Community ☐ Public

Comments: Two options for repair, owner chose to add line below system instead of pump to repair area at rd. Install D-box and feed existing drainfield first. Extend existing bed 35 more. Feed Repair line Last. Keep it 6' from any part of existing system. Step downs may be required to keep system on grade Install system as shallow as possible. Pump to repair option available if needed for future repair.

INITIAL SITE SKETCH

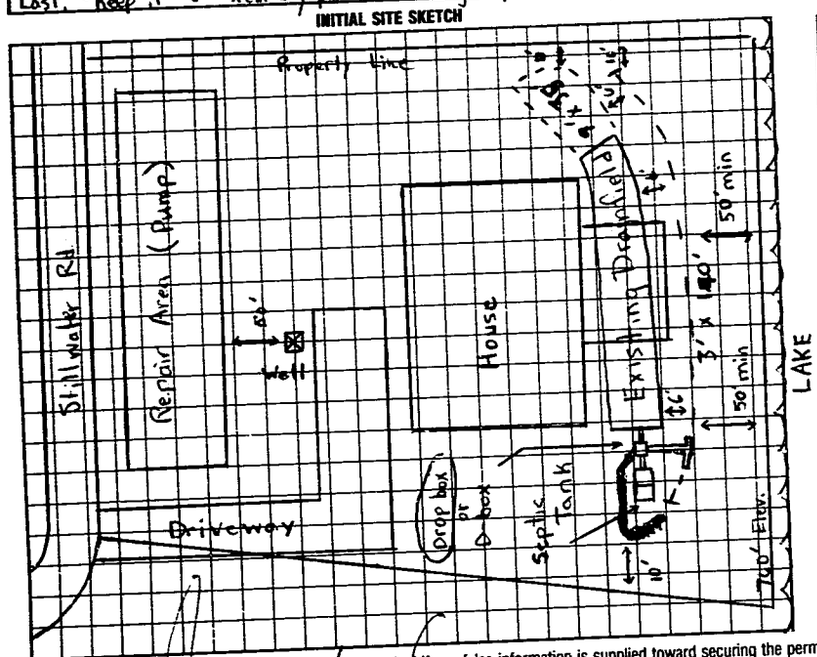

AS BUILT SKETCH

SAME AS INITIAL SKETCH

* 3' line open to some rain, and soil damp when line covered. May affect life span of system.
* Repair Area up at rd. for future repair.

I understand that this permit can be suspended or revoked if any false information is supplied toward securing the permit/any unauthorized changes are made to the site/any unauthorized changes are made in the installation of the system. Improvement Permit is valid for 60 months from date of issuance.

Signed: Douglas G. Eisele

Improvement Permit by: Michael J. Dennis date 11-29-93

Existing System Inspection by: — date —

Installed by: Wes Lytton

Certificate of Completion by: Michael J. Dennis date 12-10-93

Operation Permit by: — date —

HEALTH DEPT. COPY: WHITE INSPECTION COPY (FINAL): GREEN OWNER COPY (FINAL): YELLOW INSPECTION COPY (INITIAL): PINK OWNER COPY (INITIAL): GOLD