IREDELL COUNTY HEALTH DEPARTMENT

STATESVILLE 704-878-5305 MOORESVILLE 704-664-5281

IMPROVEMENT PERMIT / CERTIFICATE OF COMPLETION / OPERATION PERMIT / EXISTING SYSTEM INSPECTION

PROPERTY DESCRIPTION NO. 21363 DATE 6-16-95 TAX MAP NO. 3C-3-A-18 Watershed: ☐ Yes ☒ No

OWNER OR CONTRACTOR Bright Star Dev. Co. PHONE: Business Home 664-0809

ADDRESS 777 Oak Ridge Farm Rd. Mooresville, N.C. 28115

LOCATION From Trantham Lake Perth Rd TR State Park Rd TL Mooresville Farm Rd TR Stillwater ≈ 1.5 miles on L

SUBDIVISION Crescent BLOCK / SECTION 18 LOT 18 LOT AREA 156 x 264 SITE CLASS Existing DESIGN FLOW 240 L.T.A.R. Existing

Septic Tank: Gallons; STB Date

Pump Tank: Existing Gallons; PT Date

Pump Make: Model System Serial No. Inspection

Nitrification Field: No Fields Square Feet Linear Feet

No Lines Trench Width Max Trench Bottom Depth Gravel Depth

☐ New System ☐ Repair System Type: I, II, III, IV, V, VI

System Description: Existing System

Repair System Description: Inspection

Maintenance Agreement Required: ☐ Yes ☐ No

☐ Slab ☐ Crawl Space ☒ Basement w/plumbing ☐ Basement wo/plumbing

☒ House/Mod. Home ☐ Mobile Home ☐ Business ☐ Other

No. Bedrooms 2 No. Bathrooms 2 No. Employees


Water Supply: ☒ Individual ☐ Community ☐ Public

Comments:

Comments: Moved off 3 Bedroom SW MH. Replacing with 2 Bedroom House. System shows no visible signs of malfunction at time of inspection. Keep house min 5' from any part of septic system.

INITIAL SITE SKETCH

AS BUILT SKETCH

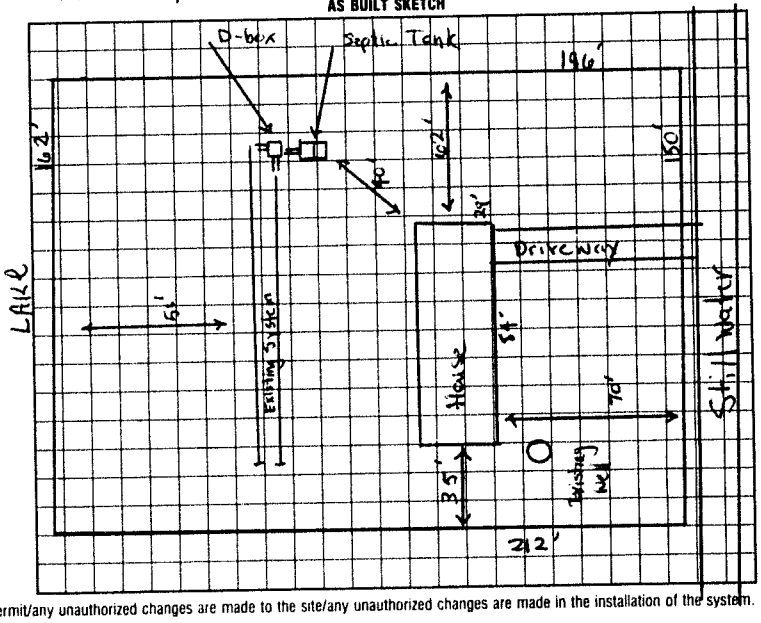

I understand that this permit can be suspended or revoked if any false information is supplied toward securing the permit/any unauthorized changes are made to the site/any unauthorized changes are made in the installation of the system. Improvement Permit is valid for 60 months from date of issuance.

Signed:

Improvement Permit by: date

Existing System Inspection by: Michael J. O'Connor date 6-16-95

Installed by:

Certificate of Completion by: date

Operation Permit by: date

HEALTH DEPT. COPY: WHITE INSPECTION COPY (FINAL): GREEN OWNER COPY (FINAL): YELLOW INSPECTION COPY (INITIAL): PINK OWNER COPY (INITIAL): GOLD