IREDELL COUNTY HEALTH DEPARTMENT

STATESVILLE 704-878-5305 MOORESVILLE 704-664-5281

IMPROVEMENT PERMIT / AUTHORIZATION TO CONSTRUCT / OPERATION PERMIT / EXISTING SYSTEM INSPECTION

PERMIT# 112251 PIN# 4639-06-1827 DATE 06/02/03

OWNER OR CONTRACTOR MICHAEL E. McConnell PHONE: Business 1-803-345-4676 Home 704-528-3541

ADDRESS 207 STILLWATER RD. TROUTMAN, NC 28166

LOCATION STATE PARK RD., (L) MORRISON FRM RD., (L) STILLWATER, ON LEFT @ BOX # 207.

SUBDIVISION — BLOCK / SECTION — LOT — LOT AREA 0.74 ACRES SITE CLASS. EXISTING DESIGN FLOW [redacted] GPD L.T.A.R. EXISTING.

Septic Tank: 1,000 Gallons; STB ____ Date ____

Pump Tank: ____ Gallons; PT ____ Date ____

Pump Make: ____ Model ____ Serial No. ____

Nitrification Field: No Fields 1 Square Feet 720 Linear Feet 240

No Lines 2@120' Trench Width 36" Max Trench Bottom Depth — Gravel Depth 12"

☐ New System ☐ Repair System Type: I (II) III, IV, V, VI

System Description: EXISTING; CONVENTIONAL, GRAV,

Repair System Description: ____

Maintenance Agreement Required: ☐ Yes ☒ No

☒ House/Mod. Home No. Bedrooms 3

☐ Mobile Home No. Bathrooms 2

☐ Business No. Employees ____

☐ Other ____

☐ Slab ☒ Crawl Space ☐ Basement w/plumbing ☐ Basement wo/plumbing


Water Supply: ☒ Individual ☐ Public ☐ Community EXISTING WELL

Comments:/Conditions:


Comments:/Conditions:

* EXISTING SYSTEM INSPECTION *

INITIAL SITE SKETCH

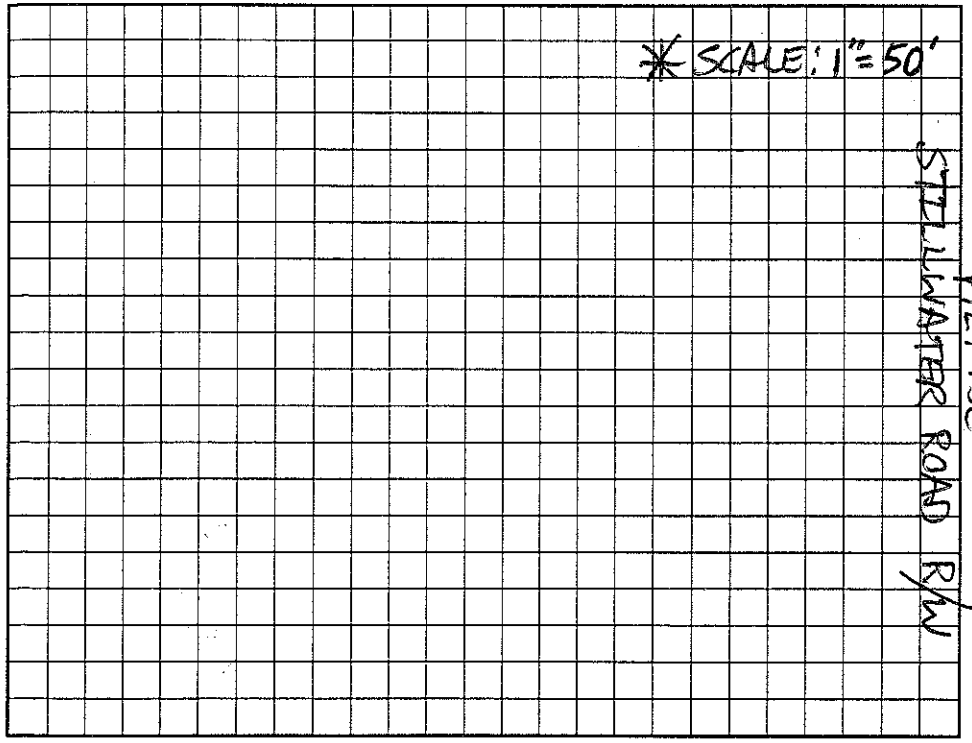

AS BUILT SKETCH

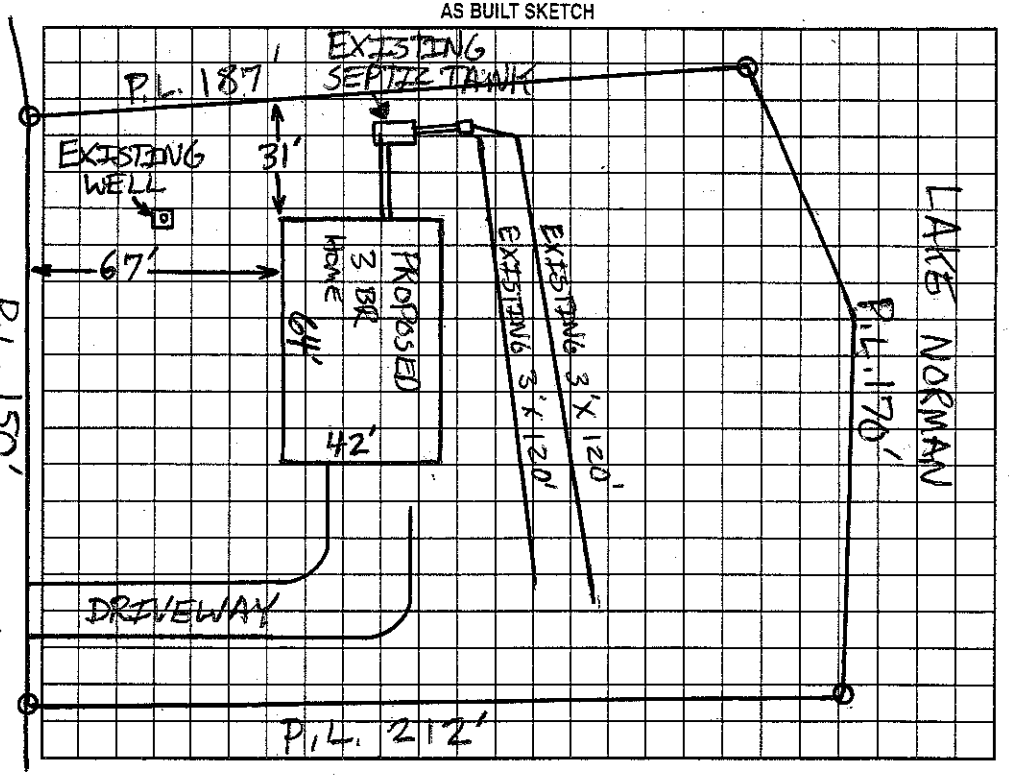

Permit can be suspended or revoked if any false information is supplied toward securing the permit/any unauthorized changes are made to the site/any unauthorized changes are made in the installation of the system. Improvement Permit with plat valid without expiration. Improvement Permit with site plan valid for sixty months. Authorization to Construct is valid for a period equal to that of Improvement Permit – not to exceed sixty months.

Signed: Michael E. McConnell date 6-6-03

Improvement Permit by: ____ date ____

Authorization to Construct by: ____ date ____

Installed by: ____

Operation Permit by: ____ date ____

Existing System Inspection by: Patrick Mitchell date 06/02/03

HEALTH DEPT. COPY: WHITE OWNER COPY (FINAL): YELLOW OWNER COPY (INITIAL): PINK