IREDELL COUNTY HEALTH DEPARTMENT

STATESVILLE 704-878-5305 MOORESVILLE 704-664-5281

IMPROVEMENT PERMIT / AUTHORIZATION TO CONSTRUCT / OPERATION PERMIT / EXISTING SYSTEM INSPECTION

PERMIT# 60794 PIN# 4639064992 DATE 4-28-99

OWNER OR CONTRACTOR Maria morrison PHONE: Business Home 873 5060

ADDRESS 277 Sain Rd Statesville, N.C.

LOCATION Perth Rd TR State Park Rd TL morrison Fm TL Stillwater TL Honeydew 3rd on rt

SUBDIVISION Lake Norman BLOCK / SECTION 19 LOT 27 LOT AREA .65 acres SITE CLASS PS DESIGN FLOW 360 L.T.A.R. .3

Septic Tank: 1000 Gallons; STB 1012 Date 10-29-99 ✓New System ☐ Repair System Type: I, II, III, IV, V, VI

Pump Tank: Gallons; PT Date System Description: Gravity Panels

Pump Make: Model Serial No Repair System Description: LPP panels

Nitrification Field: No Fields 1 Square Feet 400 Linear Feet 200 Maintenance Agreement Required: ☐ Yes ✓ No

No Lines 3 Trench Width 24" Max Trench Bottom Depth 36" Gravel Depth N/A ☐ Slab ☐ Crawl Space ✓ Basement w/plumbing ☐ Basement wo/plumbing

✓ House/Mod. Home No. Bedrooms 3

☐ Mobile Home No. Bathrooms 2

☐ Business No. Employees


✓ Other

Water Supply: ✓ Individual ☐ Public ☐ Community


Comments/Conditions: Replacing mH with House
Replacing Existing S.T. System & well
Pb 199

Comments/Conditions: Sow Grass back over Drainfield area & Landscape So That surface water Will not stand over Septic system

INITIAL SITE SKETCH

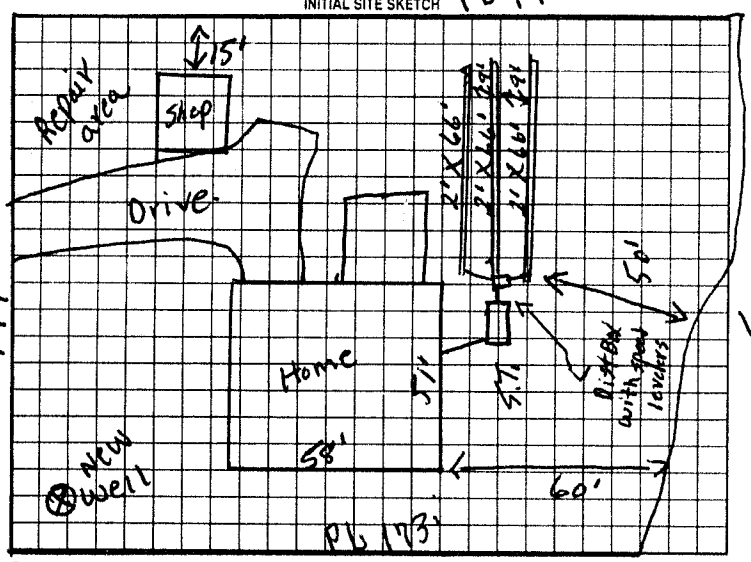

AS BUILT SKETCH

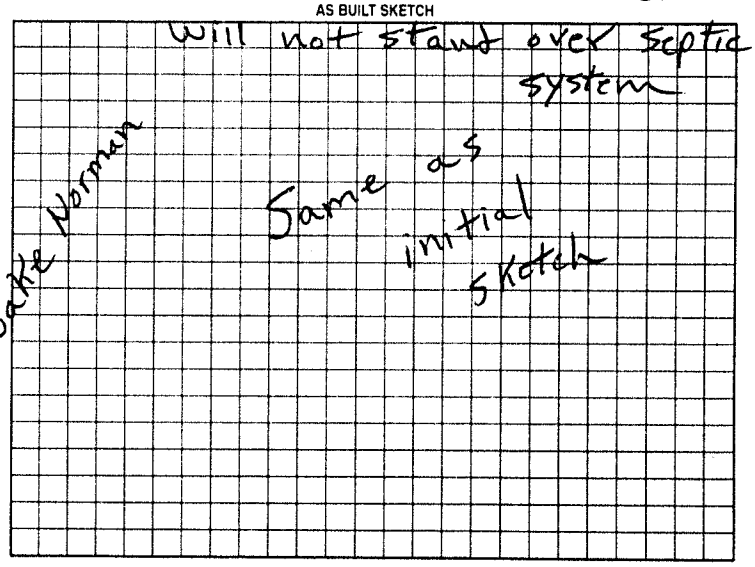

Permit can be suspended or revoked if any false information is supplied toward securing the permit/any unauthorized changes are made to the site/any unauthorized changes are made in the installation of the system. Improvement Permit with plat valid without expiration/Improvement Permit with site plan valid for sixty months. Authorization to Construct is valid for a period equal to that of Improvement Permit – not to exceed sixty months.

Signed: Maria Morrison date 5/7/99 Installed by: Steve Jordan

Improvement Permit by: J. C. Moore date 4-28-99 Operation Permit by: J. C. Moore date 1-14-00

Authorization to Construct by: J. C. Moore date 4-28-99 Existing System Inspection by: date

HEALTH DEPT COPY: WHITE OWNER COPY (FINAL): YELLOW OWNER COPY (INITIAL): PINK