IREDELL COUNTY HEALTH DEPARTMENT

(SEPTIC TANK) IMPROVEMENTS PERMIT AND CERTIFICATE OF COMPLETION
(Ground Absorption Sewage Disposal System G. S. Chapter 130-Article 13C)

OWNER OR CONTRACTOR Spencer Johnson DATE 3-20-74 PERMIT NO. _____

PHONE: Business _____ Home _____

LOCATION Turn on Perth Ch. Rd at Trentman. T.R. on State Park Rd #1321 - T.L. on Rd 1447 - T.L. on Rd 1448 - House on R. S. R. No. 1448

SUBDIVISION NAME _____ LOT NO. _____ SECTION OR BLOCK NO. _____


House (✓) Mobile Home ( ) Business ( ) Other _____

No. Bedrooms 3 No. Bathrooms 2

Garbage Disposal Unit	Yes ( )	No (✓)	
Auto. Dishwasher	Yes ( )	No (✓)	
Auto. Wash. Machine	Yes (✓)	No ( )	
Site Suitable	Yes (✓)	No ( )	

Lot Area 175 X 150

Character & Porosity of Soil _____
Percolation Rate Existing Sewage System
Topography _____
Depth to Water Table _____
Rock or other impervious formations _____

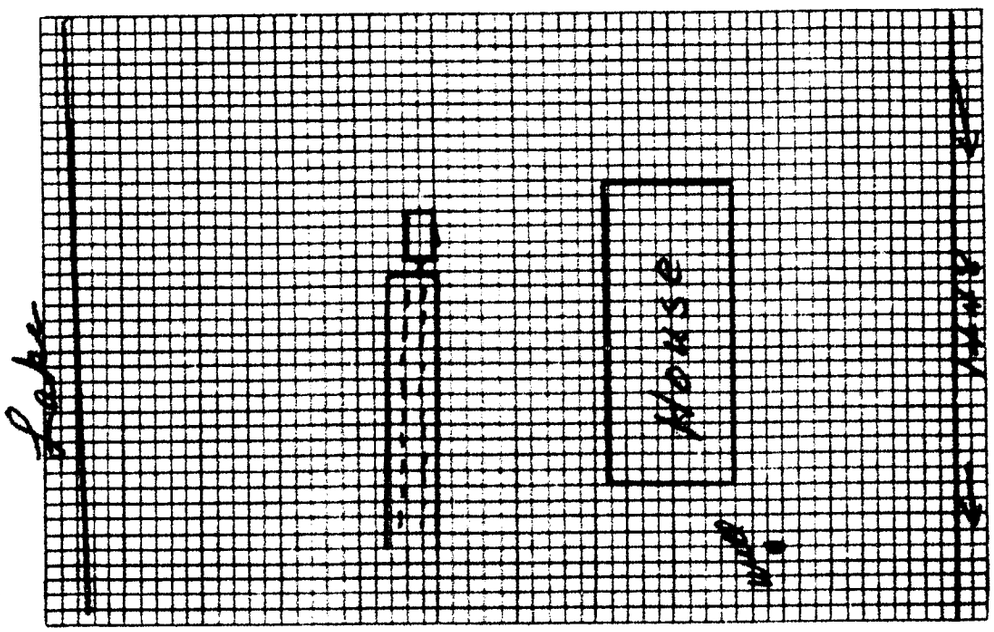

Plot of System

Size of Tank 1250 Gals.
Nitrification Field:
No. of Lines _____
Sq. Ft. _____ Linear Ft. _____
Depth of Stone in Lines _____
Water Supply: Individual (✓)
Public ( )

Installed by H. L. Hedrick
6 or 7 years ago

IMPROVEMENTS PERMIT BY E. A. Stevenson

COMMENTS: Sewage system was installed 6 or 7 years ago for a Trailer. When house is Complete Trailer will be moved. Present Sewage system seems to be working properly at this Time. If this system should give trouble later, Proper repairs will be made.

CERTIFICATE OF COMPLETION BY E. A. Stevenson DATE 3-20-74

CONSTRUCTION MUST COMPLY WITH ALL OTHER APPLICABLE STATE AND LOCAL REGULATIONS.

Health Dept. Copy: White Inspection Dept. Copy: Yellow Sanitarian's Copy: Pink Owner's Copy: Gold