IREDELL COUNTY HEALTH DEPARTMENT

Statesville Phone TR 3-7271 Mooresville Phone NO 3-1271

PERMIT TO INSTALL SEPTIC TANK

Permit NO. _____ Permit Date July 2 1964

Owner Jack Vest Address Lake Norman

Installed By C Hoke Address _____


Location of Property right at old Perth Ch. left at end of pavement left at big old home on left - left at fork on Right -

Tank		Capacity		Length of Lines		Fixtures	
Block	( )	1000	(✓)	225'	(✓)	No. of Baths	(1)
Precast	(✓)	1250	( )	250'	( )	Dishwasher	( )
		1500	( )	Other _____		Garbage Grdr.	( )
		Other _____				Other _____	

NOTIFY HEALTH DEPARTMENT AT LEAST EIGHT HOURS BEFORE TANK IS TO BE INSPECTED

Final Inspection 7-4 1964 Approved (✓) ~~Disapproved~~ ( )

Remarks well 50' weekend cabin

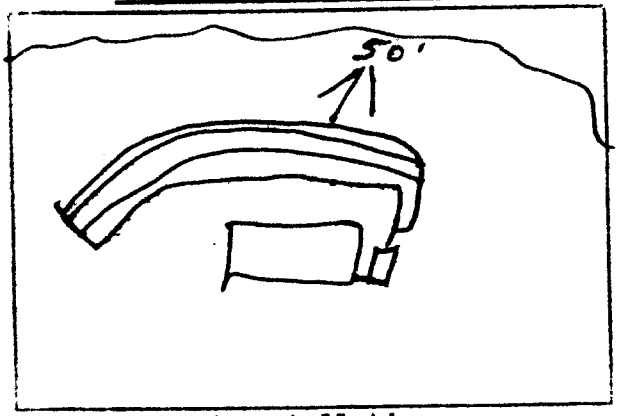

fifty feet from high water

Sketch of Installation

Sweet

Sanitarian