IREDELL COUNTY HEALTH DEPARTMENT

Statesville Office (704) 878-5305 Mooresville Office (704) 660-3625 PERMIT # 21455

IMPROVEMENT PERMIT / AUTHORIZATION TO CONSTRUCT / OPERATION PERMIT / EXISTING SYSTEM

PIN # 4639074037

APPLICANT: Milhaven Properties / Tony Hartman APPLICANT ADDRESS: 3622 Milhaven Rd Winston Salem, NC 27106

SITE ADDRESS: 158 Honeydew Circle Troutman, NC PHONE: ALT. PHONE: 336-399 8679

SITE DIRECTIONS: Perth Rd TR State Park Rd TL Morrison Farm Rd TL Stillwater TL Honeydew on right

SUBDIVISION: Cl & T SECTION: 18 LOT # 892 LOT AREA: .76Ac DESIGN FLOW: 360gpd L.T.A.R.: .85

Septic Tank 1000 (gal) STB Date
Pump Tank (gal) PT Date
Pump Make Model Serial #
Nitrification Fields 1 # Lines 1 Linear Ft: 20ft
Trench Width 36" Max. Trench Bottom Depth 36" Gravel Depth N/A

☐ New System ☐ Repair ☒ Expansion System Type: I II (III) IV V VI
System Description: Gravity - 25% Reduction
Repair System Description: PPBPS Pretreatment & Drip
Maintenance Agreement Required: ☐ YES ☐ NO ☐ GRAVITY ☐ PRESSURE


☒ Residence No. Bedrooms 3
☐ Business No. Persons 6
☐ Other No. Employees
☐ Slab ☒ Crawl Space
☐ Basement w/plumbing ☐ Basement w/o plumbing

Water Supply: ☐ Private ☐ Public ☐ Community

Comments / Conditions: 36" if 100ft from well.

Notes Corner of Deck Addition was built to close to existing drainfield. Therefore, 20ft of drainfield that's 45ft from Deck footer must be abandoned & SDLid pipe through area until

INITIAL SITE SKETCH

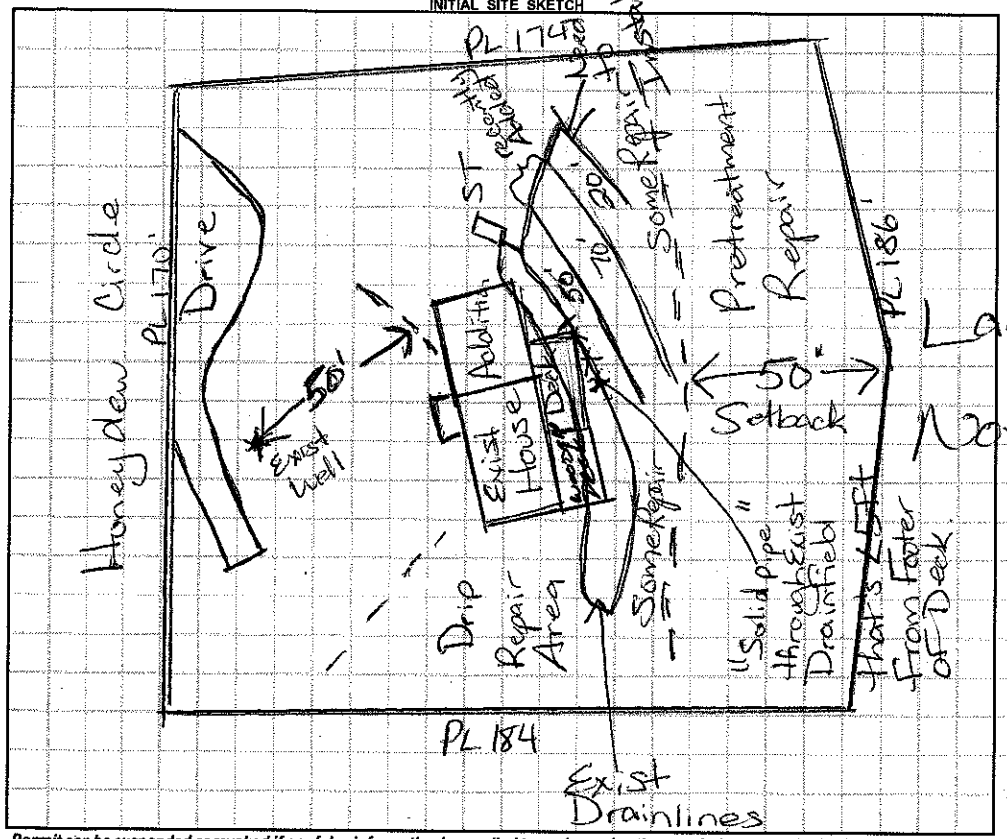

AS BUILT SKETCH

Scale 1:50

drainfield setback is at least 5ft. Add an additional 20ft drainline below newly installed drainline

Steps from Deck Have No Foundation. No Setback. Rest of Deck Cantilevered. Post are 5' from Drainfield. Prior Permit from 12/30/15 was Revoked. This Permit is Valid OP.

Permit can be suspended or revoked if any false information is supplied toward securing the permit / any unauthorized changes are made to the site / any unauthorized changes are made in the installation of the system. **CONTACT A LOCATOR SERVICE PRIOR TO ANY EXCAVATION**

☐ **IMPROVEMENT PERMIT** *with plat valid without expiration.* ☒ **IMPROVEMENT PERMIT** *with site plan valid for 60 mos.* ☒ **AUTHORIZATION TO CONSTRUCT** *valid for period equal to IMPROVEMENT PERMIT--not to exceed 60 mo.*

Owner / Applicant Signature: Date: 5/25/16 Installed by: DARYL SALMONS

IMPROVEMENT PERMIT by: Date: 5/17/16 OPERATION PERMIT by: APPROVED JUN 20 2016

AUTHORIZATION TO CONSTRUCT by: Date: 5/17/16 Existing System Inspected by: Date:

Health Dept. Copy - WHITE Applicant (Final Approval) - YELLOW Applicant (Conditional Approval) - PINK