IREDELL COUNTY HEALTH DEPARTMENT

Statesville Office (704) 878-5305, Mooresville Office (704) 660-3625

PERMIT # ~~17655~~ 212900

IMPROVEMENT PERMIT / AUTHORIZATION TO CONSTRUCT / OPERATION PERMIT / EXISTING SYSTEM

PIN # ~~4639-09-1090~~ 4639074754

APPLICANT: JAMES E. SCHNEIDER APPLICANT ADDRESS: 1977 WEST EMERYS CHURCH RD LINDEN, PA 17744

SITE ADDRESS: HONEYDEW CIRCLE PHONE: 704-202-5291 ALT. PHONE:

SITE DIRECTIONS: STATE PARK ROAD TO MORRISON FARM RD, TL STILLWATER RD, TL HONEYDEW CIRCLE LOT ON LEFT


SUBDIVISION: TWINN COVES ON MORRISON SECTION: N/A LOT # 4 LOT AREA: 5.04 ACRES DESIGN FLOW: 600 L.T.A.R.: 0.30 GPD/FT²

Septic Tank	1500 (gal)	STB	444	Date	3-18-16	☑ New System ☐ Repair ☐ Expansion	System Type: I II (III) IV V VI	☑ Residence	No. Bedrooms 5
Pump Tank	1500 (gal)	PT	477	Date	3-18-16	System Description: 25% REDUCTION, PUMP		☐ Business	No. Persons
Pump Make		Model		Serial #		Repair System Description: 50% REDUCTION, LOW-PRESSURE		☐ Other	No. Employees
# Nitrification Fields	1	# Lines	FOUR	Linear Ft:	500	Maintenance Agreement Required: ☐ YES	☑ NO	☑ Slab	[redacted]
Trench Width	36"	Max. Trench Bottom Depth	28"	Gravel Depth	N/A	☐ GRAVITY	☑ PRESSURE	☑ Basement w/plumbing	☐ Basement w/o plumbing

Water Supply: ☑ Private WELL ☐ Public ☐ Community

Comments / Conditions: INSTALL 25% REDUCTION SYSTEM ACCORDING TO "FAST TRACK" PLAN PREPARED BY ADRIAN L. PRUETT CAROLINA SOIL & SEPTIC CONSULTING, PLLC

INITIAL SITE SKETCH

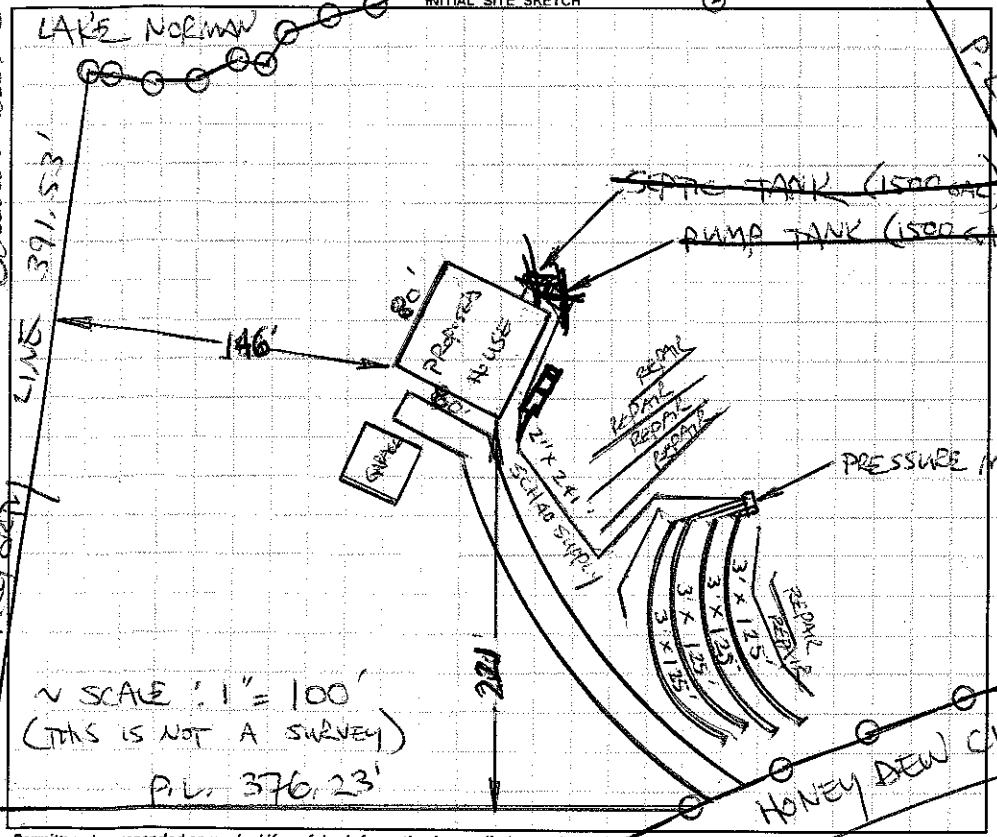

AS BUILT SKETCH

Polylok PL-68 FILTER

Installed

Quirky as drawn

Lock Filter

	Date	Initials
Drain Lines Checked	04/21/16	[redacted]
Tanks Checked	04/21/16	[redacted]
Pressure Manifold or Valve Box Checked	07/21/16	HS
Pressure Head Set	07/21/16	HS
Electrical Checked	[redacted]	
Floats Set	07/21/16	HS
Alarm Checked	07/21/16	HS
Maintenance Contract Y / N	N/A	

Need to grade off Septic pump tank area add 6" riser raise control panel to 12"

Permit can be suspended or revoked if any false information is supplied toward securing the permit / any unauthorized changes are made to the site / any unauthorized change

☑ **IMPROVEMENT PERMIT** *with plat* valid without expiration. ☐ **IMPROVEMENT PERMIT** *with site plan* valid for 60 mos. ☒ **AUTHORIZATION TO CONSTRUCT** valid for period equal to IMPROVEMENT PERMIT--not to exceed 60 mo.

Owner / Applicant Signature: Date: 3-15-13 Installed by: Richard Abogan at hwy

IMPROVEMENT PERMIT by: R. STEVE HEDRICK Date: 3-15-2013 OPERATION PERMIT by: Date: 08/02/16

AUTHORIZATION TO CONSTRUCT by: Date: 08/17/16 Existing System Inspected by: Date:

Health Dept. Copy - WHITE Applicant (Final Approval) - YELLOW Applicant (Conditional Approval) - PINK