IREDELL COUNTY HEALTH DEPARTMENT

STATESVILLE 704-878-5305 MOORESVILLE 704-664-3

IMPROVEMENT PERMIT / CERTIFICATE OF COMPLETION / OPERATION PERMIT / EXISTING SYSTEM IN[illegible]CTION

PROPERTY DESCRIPTION NO. 066678 DATE 6/30/97 TAX MAP NO. 4639102178O Watershe[illegible]

OWNER OR CONTRACTOR RON IVESTER PHONE: Business _____ Home 910-661-5638 ☐ Ne[illegible]

ADDRESS 6646 SPRINGFIELD DR. CLEMMONS NC 27012

LOCATION PERTH N - TL FERN HILL - TR PERRYWINKLE - TR QUAIL RUN - AT END

SUBDIVISION CLAY BLOCK / SECTION 15 LOT 145 LOT AREA .78 AC SITE CLASS. DS DESIGN FLOW 360 GPD L.T.A.R. ~.3

Septic Tank: EXISTING Gallons; STB _____ Date _____

Pump Tank: _____ Gallons; PT _____ Date _____

Pump Make: _____ Model _____ Serial No. _____

Nitrification Field: No Fields 1 Square Feet 154 Linear Feet 67

No Lines 1 Trench Width 24" Max Trench Bottom Depth 36" Gravel Depth N/A

☑ New System ☐ Repair System Type: I, II, III, IV, V, VI

System Description: GRAVITY PANEL

Repair System Description: - SAME

Maintenance Agreement Required: ☐ Yes ☑ No

☑ House/Mod. Home No. Bedrooms 3

☑ Mobile Home No. Bathrooms 2

☐ Business No. Employees ____

☐ Other _____

☐ Slab ☑ Crawl Space ☑ Basement w/plumbing ☐ Basement wo/plumbing

Water S[illegible]

☑ Individ


☐ Comm

☐ Public


Comments: MOBILES HOMES ARE TO BE REMOVED BEFORE HOUSE CAN BE OCCUPIED.

Comments: MH & HOUSE

INITIAL SITE SKETCH 1"= 50'

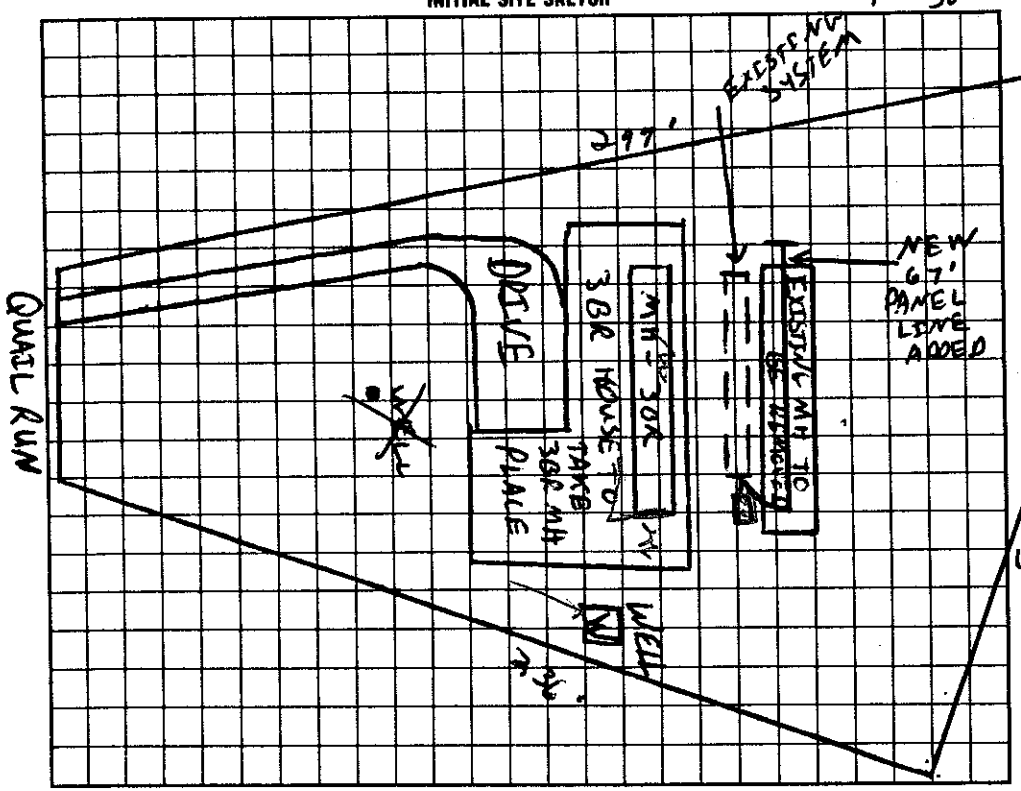

AS BUILT SKETCH

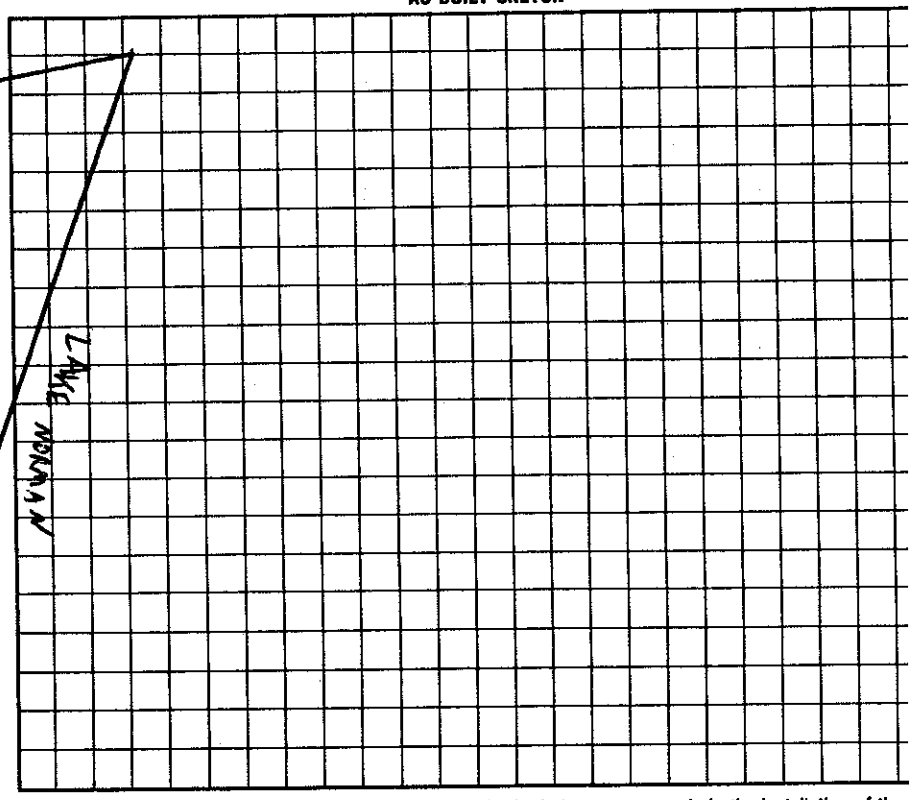

I understand that this permit can be suspended or revoked if any false information is supplied toward securing the permit/any unauthorized changes are made to the site/any unauthorized changes are made in the installation of the Improvement Permit is valid for 60 months from date of issuance.

Signed: Ron Ivester

Improvement Permit by: C. Ray Teer date 6/30/97

AUTHORIZATION TO CONSTRUCT Existing System Inspection by: C. Ray Teer date 6/30/97

Installed by: DONALD LACKEY

Certificate of Completion by: _____ date _____

Operation Permit by: C. Ray Teer date 1/1[illegible]

HEALTH DEPT. COPY: WHITE INSPECTION COPY (FINAL): GREEN OWNER COPY (FINAL): YELLOW INSPECTION COPY (INITIAL): PINK OWNER COPY (INITIAL): GOLD