IREDELL COUNTY HEALTH DEPARTMENT

STATESVILLE 704-878-5305 MOORESVILLE 704-664-5281

IMPROVEMENT PERMIT / AUTHORIZATION TO CONSTRUCT / OPERATION PERMIT / EXISTING SYSTEM INSPECTION

PERMIT# 083946 PIN# 4639 11 1264 DATE 10/18/99

OWNER OR CONTRACTOR Frank Ebert PHONE: Business Home 873-1175

ADDRESS 608 Foxcroft Terrace Statesville NC 28677

LOCATION Perth N to Fern Hill TR Riverbend Rd 1 1/2 mile on (R) 480 Awg

SUBDIVISION RIVERBEND HILLS BLOCK / SECTION LOT 4 LOT AREA 2.91 AC SITE CLASS. PS DESIGN FLOW 360 L.T.A.R. 3 Awg

Septic Tank: 1000 Gallons; STB 317 Date 12/19/99
Pump Tank: Gallons; PT Date
Pump Make: Model Serial No.
Nitrification Field: No Fields 1 Square Feet 795 * Linear Feet 266 *
No Lines 6 Trench Width 36" Max Trench Bottom Depth 36" Gravel Depth SAND


(X) New System ☐ Repair System Type: I, II, (III), IV, V, VI
System Description: GRAVITY - 4" PVC
Repair System Description: SAME - PRESSURE
Maintenance Agreement Required: ☐ Yes ☐ No

(X) House/Mod. Home No. Bedrooms 4
☐ Mobile Home No. Bathrooms 3
☐ Business No. Employees
☐ Other
☐ Slab ☐ Crawl Space (X) Basement w/plumbing ☐ Basement wo/plumbing

Water Supply: (X) Individual ☐ Public ☐ Community

Comments:/Conditions:

INITIAL SITE SKETCH

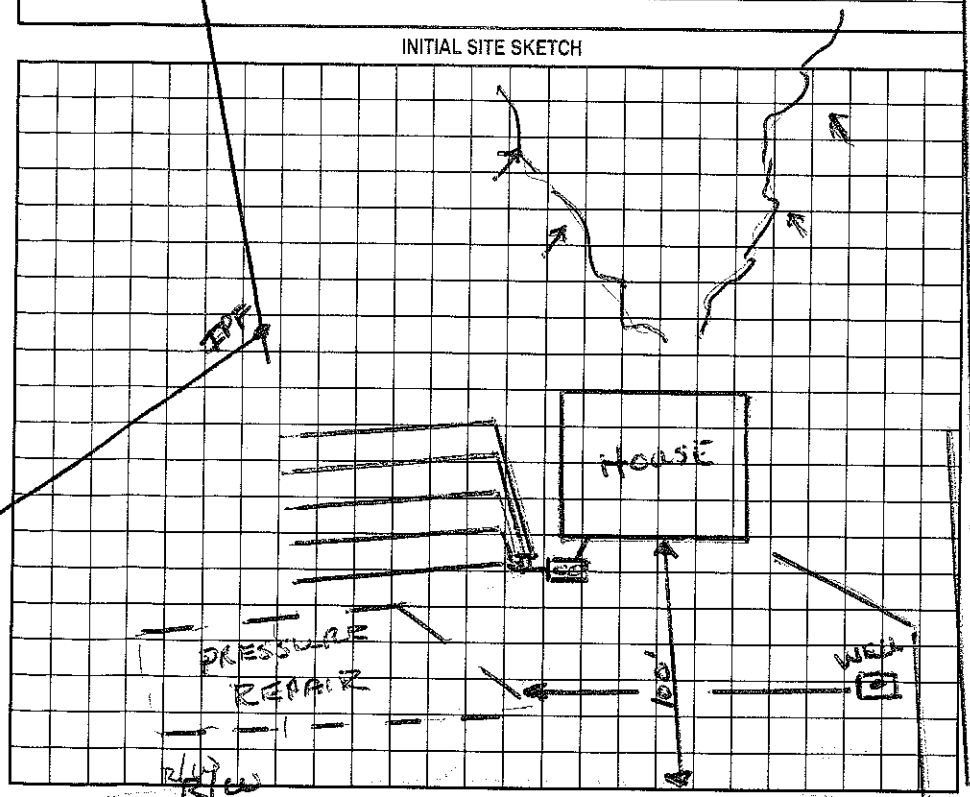

Comments:/Conditions:

AS BUILT SKETCH

Permit can be suspended or revoked if any false information is supplied toward securing the permit/any unauthorized changes are made to the site/any unauthorized changes are made in the installation of the system. Improvement Permit with plat valid without expiration. Improvement Permit with site plan valid for sixty months. Authorization to Construct is valid for a period equal to that of Improvement Permit – not to exceed sixty months.

Signed: * C. W. Hudson date 10/18/99 Installed by: H + R Grading

Improvement Permit by: Wesley Sparks RS. date 10/18/99 Operation Permit by: Wesley Sparks RS. date 2/21/00

Authorization to Construct by: Wesley Sparks RS date 10/18/99 Existing System Inspection by: date

HEALTH DEPT. COPY: WHITE OWNER COPY (FINAL): YELLOW OWNER COPY (INITIAL): PINK