IREDELL COUNTY HEALTH DEPARTMENT

STATESVILLE 704-878-5305 MOORESVILLE 704-664-5281

IMPROVEMENT PERMIT / CERTIFICATE OF COMPLETION / OPERATION PERMIT / EXISTING SYSTEM INSPECTION

PROPERTY DESCRIPTION NO. 23941 DATE 6/20/96 TAX MAP NO. 3-C-10-A-155 Watershed: ☑ Yes ☐ No

OWNER OR CONTRACTOR William Little PHONE: Business _____ Home 910-732-5332

ADDRESS 5765 Jane Ln Winston Salem NC 27127

LOCATION Person Rd S. TR Fern Hill Rd - TR Forest Lane Lot at end

SUBDIVISION _____ BLOCK / SECTION _____ LOT 178 LOT AREA _____ SITE CLASS. RS DESIGN FLOW 360 L.T.A.R. .4 gal/sq

Septic Tank: Existing Gallons; STB _____ Date _____

Pump Tank: _____ Gallons; PT _____ Date _____

Pump Make: _____ Model _____ Serial No. _____

Nitrification Field: No Fields 1 Square Feet 300 Linear Feet 100

No Lines 1 Trench Width 36" Max Trench Bottom Depth 36" Gravel Depth 6"

☑ New System ☐ Repair System Type: I II III IV V VI

System Description: Gravity Conventional

Repair System Description: Pump Panel

Maintenance Agreement Required: ☐ Yes ☑ No

☑ House/Mod. Home No. Bedrooms 3

☐ Mobile Home No. Bathrooms 2

☐ Business No. Employees _____

☐ Other _____


☐ Slab ☑ Crawl Space ☐ Basement w/plumbing ☐ Basement wo/plumbing

Water Supply: ☑ Individual ☐ Community ☐ Public

Comments: Addition to Lines approved but not existing system until lines are installed.

Comments:

INITIAL SITE SKETCH

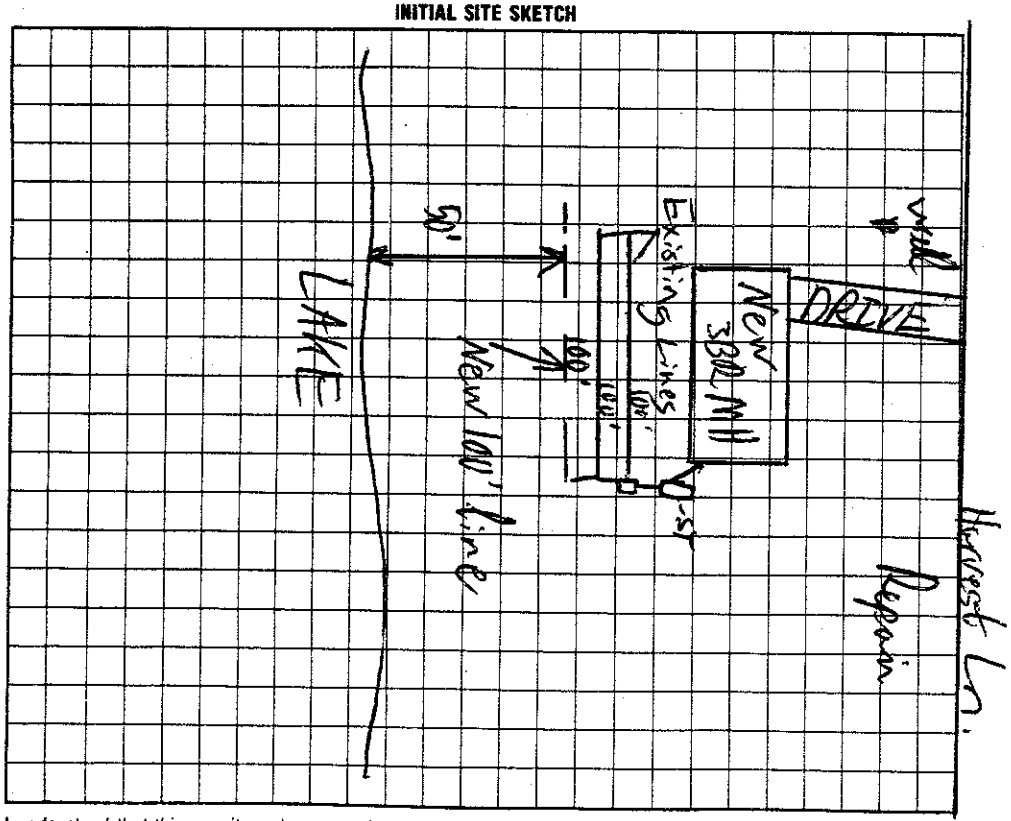

AS BUILT SKETCH

I understand that this permit can be suspended or revoked if any false information is supplied toward securing the permit/any unauthorized changes are made to the site/any unauthorized changes are made in the installation of the system.

Signed: William P. Little, Jr.

Improvement Permit by: C. Barry Thomas EHS date 6/20/96

Existing System Inspection by: C. Barry Thomas EHS date 6/20/96

Installed by: A-1 BACKHOE

Certificate of Completion by: _____ date _____

Operation Permit by: C. Barry Thomas EHS date 8/27/96

HEALTH DEPT. COPY: WHITE INSPECTION COPY (FINAL): GREEN OWNER COPY (FINAL): YELLOW INSPECTION COPY (INITIAL): PINK OWNER COPY (INITIAL): GOLD