4639-12-[redacted] 2208

# IREDELL COUNTY HEALTH DEPARTMENT

STATESVILLE 704-878-5305 MOORESVILLE 704-664-5281

## IMPROVEMENT PERMIT / CERTIFICATE OF COMPLETION / OPERATION PERMIT / EXISTING SYSTEM INSPECTION

PROPERTY DESCRIPTION NO. 20253 DATE 2/13/95 TAX MAP NO. 3C 10A 193 Watershed: ☒ Yes ☐ No

OWNER OR CONTRACTOR John F. Eisele PHONE: Business _____ Home 528-3330

ADDRESS 134 Vernus Ln. Mooresville, NC. 28115

LOCATION Vernus Ln. Fern Hill TR on Riverwood (R) on Carlton (L) on Vernus to 2ND house on (R)

SUBDIVISION CLRT BLOCK / SECTION 15 LOT 193 (959) LOT AREA 2.75AC SITE CLASS. P DESIGN FLOW 360 L.T.A.R. _____

Septic Tank: Existing Gallons; STB _____ Date _____

Pump Tank: Existing Gallons; PT _____ Date _____

Pump Make: _____ Model _____ Serial No. _____

Nitrification Field: No Fields 2 Square Feet 1785 Linear Feet 595

No Lines 8 Trench Width 36" Max Trench Bottom Depth 30" Gravel Depth 12"

☐ New System ☐ Repair System Type: I, II, III, (V) V, VI

System Description: Existing System

Repair System Description: _____

Maintenance Agreement Required: ☒ Yes ☐ No ANNUAL

☒ House/Mod. Home No. Bedrooms 3

☐ Mobile Home No. Bathrooms 2

☐ Business No. Employees _____

☐ Other _____

☐ Slab ☐ Crawl Space ☒ Basement w/plumbing ☐ Basement wo/plumbing


Water Supply:
☐ Individual
☐ Community
☐ Public

Comments:

Comments:

**INITIAL SITE SKETCH**

**AS BUILT SKETCH**

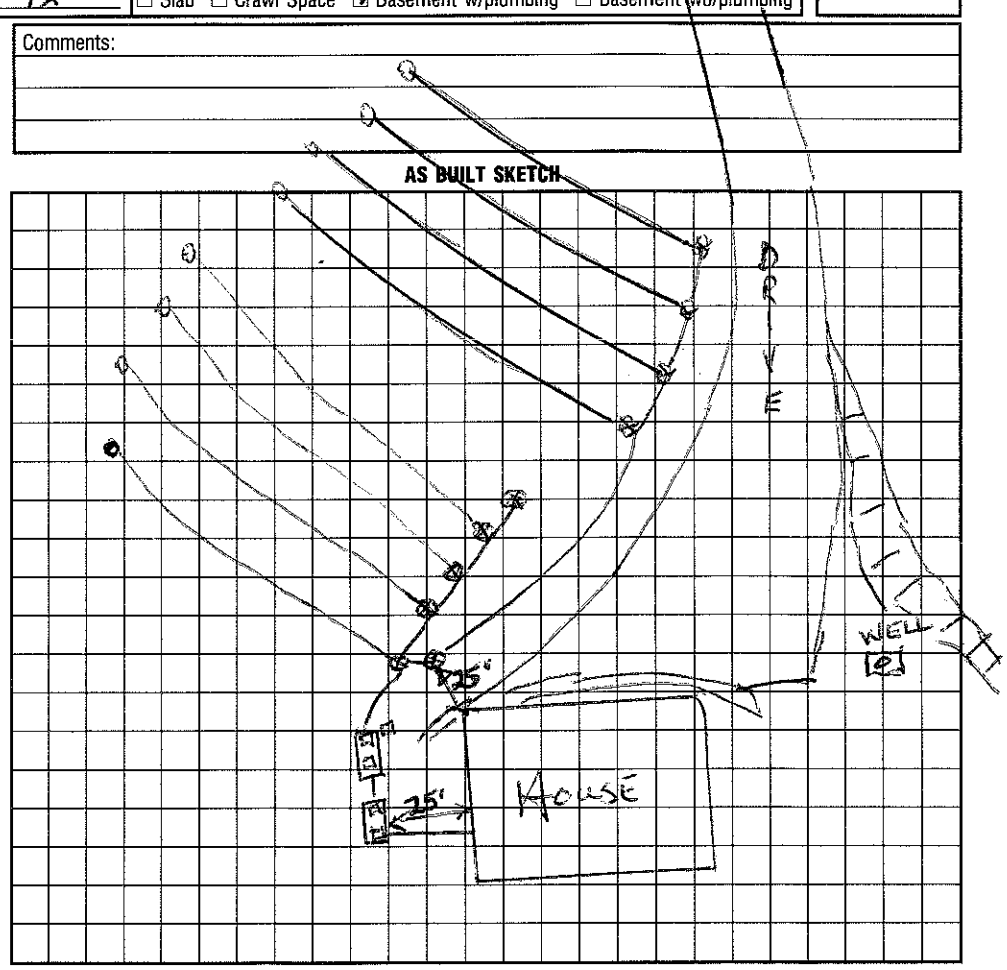


I understand that this permit can be suspended or revoked if any false information is supplied toward securing the permit/any unauthorized changes are made to the site/any unauthorized changes are made in the installation of the system. Improvement Permit is valid for 60 months from date of issuance.

Signed: _____ Installed by: _____

Improvement Permit by: _____ date _____ Certificate of Completion by: _____ date _____

Existing System Inspection by: Wesley Sparks RS. date 2/13/95 Operation Permit by: _____ date _____

HEALTH DEPT. COPY: WHITE INSPECTION COPY (FINAL): GREEN OWNER COPY (FINAL): YELLOW INSPECTION COPY (INITIAL): PINK OWNER COPY (INITIAL): GOLD