IREDELL COUNTY HEALTH DEPARTMENT Const. Auth. STATESVILLE 704-878-5305 MOORESVILLE 704-664-5281

IMPROVEMENT PERMIT / ~~CERTIFICATE OF COMPLETION~~ / OPERATION PERMIT / EXISTING SYSTEM INSPECTION

PROPERTY DESCRIPTION NO. 070119 DATE Nov. 3, '97 TAX MAP NO. 4639/23947 Watershed: ☑ Yes ☐ No

OWNER OR CONTRACTOR James Hetrick PHONE: Business _____ Home _____

ADDRESS 16709 Redcliff Dr. Apt. N, Huntersville NC 28078

LOCATION Fern Hill Rd. - TR Riverbend TR Carlton on right before end

SUBDIVISION Crescent BLOCK / SECTION 15 LOT 953 LOT AREA 1.4Ac SITE CLASS. PS DESIGN FLOW 360gpd L.T.A.R. .3

Septic Tank: 1000 Gallons; STB 754 Date 4/23/98
Pump Tank: 1000 Gallons; PT 47 Date 5/22/98
Pump Make: Goulds Model WE0511M Serial No. M9728617
Nitrification Field: No Fields 1 Square Feet 1200 Linear Feet 400
No Lines 4@100' Trench Width 36" Max Trench Bottom Depth 18" Gravel Depth 12"

☑ New System ☐ Repair System Type: I, II, (III), IV, V, VI
System Description: pumped fm - shallow conventional
Repair System Description: Same / LPP
Maintenance Agreement Required: ☐ Yes ☑ No

☑ House/Mod. Home No. Bedrooms 3
☐ Mobile Home No. Bathrooms 2
☐ Business No. Employees ____
☐ Other ____


☐ Slab ☐ Crawl Space ☑ Basement w/plumbing ☐ Basement wo/plumbing

Water Supply:
☑ Individual
☐ Community
☐ Public

Comments: 18" MAXIMUM trench bottom depth on lower side of trenches

Comments:

INITIAL SITE SKETCH 1"=60'

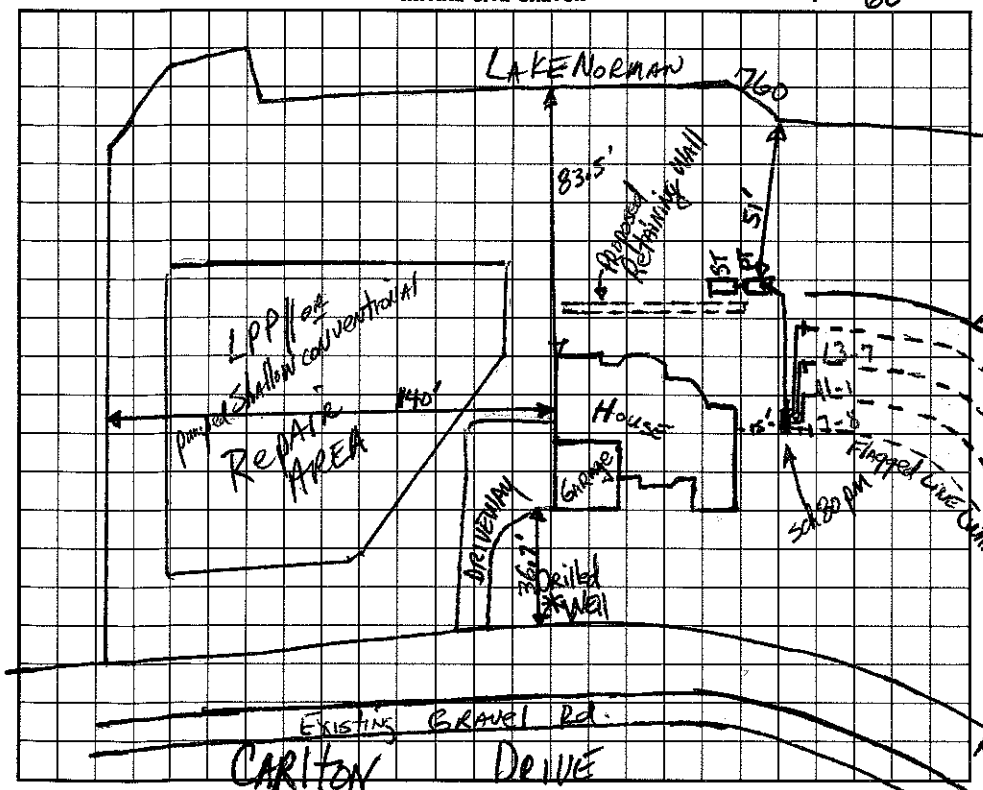

AS BUILT SKETCH

I understand that this permit can be suspended or revoked if any false information is supplied toward securing the permit/any unauthorized changes are made to the site/any unauthorized changes are made in the installation of the s[illegible]m. Improvement Permit is valid for 60 months from date of issuance.

Signed: [signature]

Improvement Permit by: DHoffman, RS date 11-3-97

~~Construction Authorization~~ by: DHoffman, RS date 11-3-97

Installed by: F J Ervin

Certificate of Completion by: Wesley Sparks RS date

Operation Permit by: Wesley Sparks RS

HEALTH DEPT. COPY: WHITE INSPECTION COPY (FINAL): GREEN OWNER COPY (FINAL): YELLOW INSPECTION COPY (INITIAL): PINK OWNER COPY (IN[illegible]