IREDELL COUNTY HEALTH DEPARTMENT

STATESVILLE 704-878-5305 MOORESVILLE 704-664-5281

IMPROVEMENT PERMIT / CERTIFICATE OF COMPLETION / OPERATION PERMIT / EXISTING SYSTEM INSPECTION

PROPERTY DESCRIPTION NO. 21915 DATE Sept 8, 195 TAX MAP NO. 3C 13A 18 4639 13 0430 Watershed: ☐ Yes ☐ No

OWNER OR CONTRACTOR Steve Ivestor / Newman McDade PHONE: Business _____ Home _____ WS4

ADDRESS 21810 Shearer Rd. Davidson

LOCATION Ramhill Rd. TR Bullfinch on left near end

SUBDIVISION Beacon Pointe BLOCK / SECTION 1 LOT 18 LOT AREA 1.03ac SITE CLASS. Pspn 1996 DESIGN FLOW 480gpd L.T.A.R. .3

Septic Tank: 1000 Gallons; STB _____ Date 2-28-96

Pump Tank: 1000 Gallons; PT 17 Date 3-11-96

Pump Make: Myers Model ME 40 MC-11 Serial No. 24819A010

Nitrification Field: No Fields 1 Square Feet 1200 Linear Feet 400

No Lines 3@134' Trench Width 36" Max Trench Bottom Depth ≈36" Gravel Depth N/A

☑ New System ☐ Repair System Type: I, II, III, IV, V, VI

System Description: pumped/pm/INSIFRATOR LPP PBPS

Repair System Description: _____

Maintenance Agreement Required: ☐ Yes ☑ No (INITIAL SYS)

☑ House/Mod. Home No. Bedrooms 4

☐ Mobile Home No. Bathrooms 4

☐ Business No. Employees _____

☐ Other _____


☐ Slab ☐ Crawl Space ☑ Basement w/plumbing ☐ Basement wo/plumbing

Water Supply: ☐ Individual ☑ Community ☐ Public

Comments: laterals to follow contour

Comments: partial lines, tanks, pump, checked on 5/3/96

INITIAL SITE SKETCH

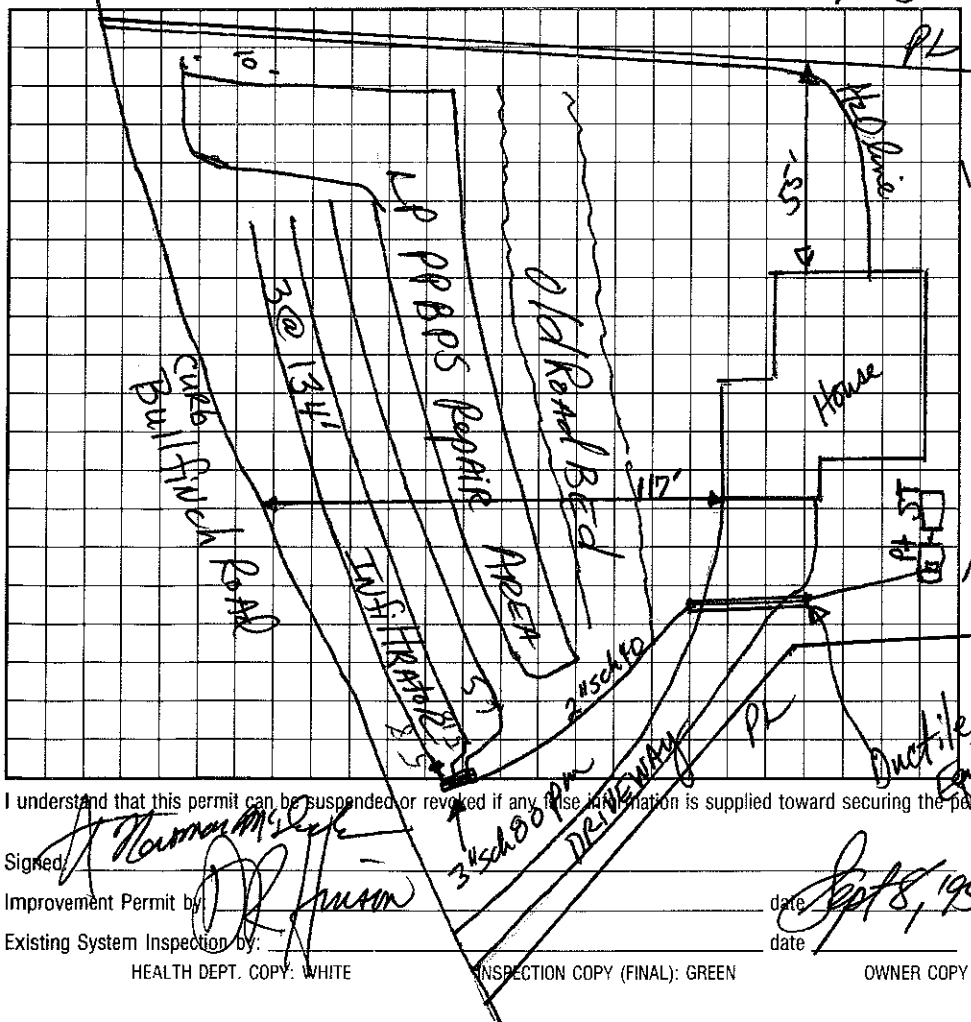

AS BUILT SKETCH

I understand that this permit can be suspended or revoked if any false information is supplied toward securing the permit/any unauthorized changes are made to the site/any unauthorized changes are made in the installation of the system.

Signed: Norman McDade

Improvement Permit by: _____ date Sept 8, 95

Existing System Inspection by: _____ date _____

Installed by: Richard Abernath.

Certificate of Completion by: _____ date _____

Operation Permit by: _____ EHST date 7/19/96

HEALTH DEPT. COPY: WHITE INSPECTION COPY (FINAL): GREEN OWNER COPY (FINAL): YELLOW INSPECTION COPY (INITIAL): PINK OWNER COPY (INITIAL): GOLD