IREDELL COUNTY HEALTH DEPARTMENT

STATESVILLE 704-878-5305 MOORESVILLE 704-664-5281

IMPROVEMENT PERMIT / AUTHORIZATION TO CONSTRUCT / OPERATION PERMIT / EXISTING SYSTEM INSPECTION

PERMIT# 081654 PIN# 4639244523 DATE 5/24/99

OWNER OR CONTRACTOR Crescent Resources PHONE: Business 663-6905 Home

ADDRESS P.O. Box 1003 Charlotte NC 28201

LOCATION Perth Rd TL Fernhill TR Bullfinch

SUBDIVISION Beacon Point BLOCK / SECTION II LOT 6 LOT AREA .852 Acre SITE CLASS PS DESIGN FLOW 480gpd L.T.A.R. .4

Septic Tank: 1000 Gallons; STB Date

Pump Tank: Gallons; P.T Date

Pump Make: Model Serial No.

Nitrification Field: No Fields 1 Square Feet 1200' Linear Feet 400'

No Lines 4at100' Trench Width 36" Max Trench Bottom Depth Gravel Depth 12"

☒ New System ☐ Repair System Type: I, II, III, IV, V, VI

System Description: Gravity - Conventional

Repair System Description: Gravity - 25% Reduction

Maintenance Agreement Required: ☐ Yes ☒ No

☒ House/Mod. Home No. Bedrooms 4

☐ Mobile Home No. Bathrooms 4

☐ Business No. Employees

☐ Other


☐ Slab ☒ Crawl Space ☐ Basement w/plumbing ☐ Basement wo/plumbing

Water Supply: ☐ Individual ☒ Public ☒ Community


Comments:/Conditions: * Any grading done to lot will require pumping to Drainlines instead of Gravity Flow.
Keep Septic System at least 10' to PL & 5' to House

Comments:/Conditions:

SCALE = 1:50 INITIAL SITE SKETCH

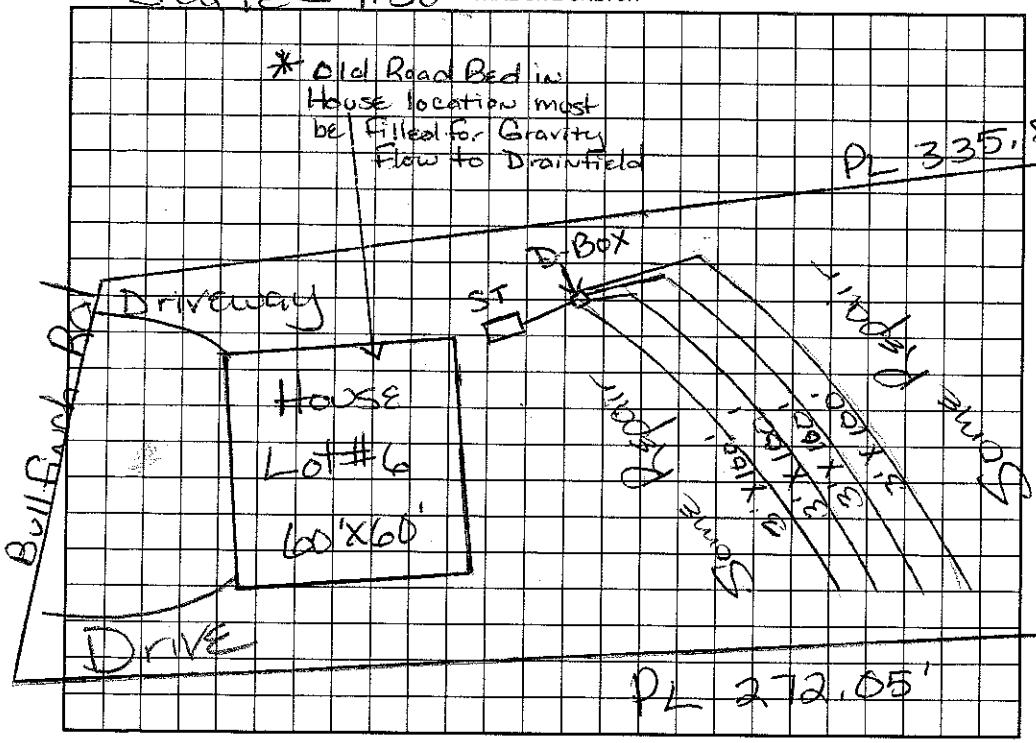

AS BUILT SKETCH

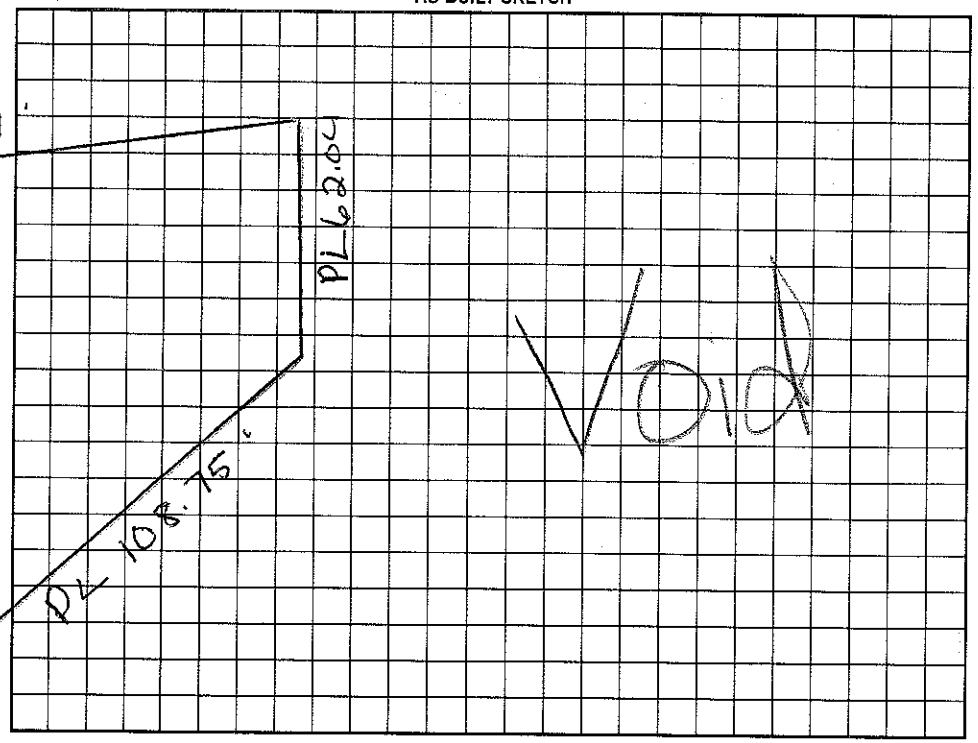

Permit can be suspended or revoked if any false information is supplied toward securing the permit/any unauthorized changes are made to the site/any unauthorized changes are made in the installation of the system. Improvement Permit with plat valid without expiration. Improvement Permit with site plan valid for sixty months. Authorization to Construct is valid for a period equal to that of Improvement Permit – not to exceed sixty months.

Signed: Tony Jack date 6-2-99

Improvement Permit by: Maria H. Hall Coleman RS date 6/2/99

Authorization to Construct by: date

Installed by:

Operation Permit by: date

Existing System Inspection by: date

HEALTH DEPT. COPY: WHITE OWNER COPY (FINAL): YELLOW OWNER COPY (INITIAL): PINK