4639-13-2865 Authorization To Construct

IREDELL COUNTY HEALTH DEPARTMENT

STATESVILLE 704-878-5305 MOORESVILLE 704-664-5281

IMPROVEMENT PERMIT / ~~CERTIFICATE OF COMPLETION~~ / OPERATION PERMIT / EXISTING SYSTEM INSPECTION

PROPERTY DESCRIPTION NO. 18864 DATE 1/15/97 TAX MAP NO. Pt of 25 A 51 Watershed: X Yes ☐ No (WS-IV CA)

OWNER OR CONTRACTOR Tommy Mason - Ray Short Bldr. PHONE: Business _____ Home _____

ADDRESS c/o Tommy Mason 168 Bradfield Dr. Mooresville, NC. 28115

LOCATION Bullfinch Rd - Fernhill TR Bullfinch - 6th on (R) past Marietta Rd.

SUBDIVISION Beacon Pointe BLOCK / SECTION 1 LOT 6 LOT AREA ~.75AC SITE CLASS. PS DESIGN FLOW 360 L.T.A.R. .25

Septic Tank: 1000 Gallons; STB 194 Date 11/12/96

Pump Tank: 1000 Gallons; PT 29 Date 11/11/96

Pump Make: Bentele Model WE0712H Serial No. K9601390

Nitrification Field: No Fields 1 Square Feet 480 Linear Feet 240+

No Lines 4 Trench Width 24" Max Trench Bottom Depth 28" Gravel Depth SAND.

X New System ☐ Repair System Type: I, II, III, (IV) V, VI

System Description: +Pressured 16"

Repair System Description: SAME

Maintenance Agreement Required: X Yes ☐ No

X House/Mod. Home ☐ Mobile Home ☐ Business ☐ Other

No. Bedrooms 3 No. Bathrooms 2 No. Employees _____

☐ Slab X Crawl Space ☐ Basement w/plumbing ☐ Basement wo/plumbing

Water Supply: ☐ Individual X Community ☐ Public


Comments: System designer will provide written certification to ICHD that final installation complies with his specifications + before issuance of Operation Permit

Comments: See consultant's plan for construction - System installed as shown by consultant

INITIAL SITE SKETCH

System designer location based on LP PANEL DESIGN by T JACOBS & ASSOC. from Revision dated Jan 9, 1997

AS BUILT SKETCH

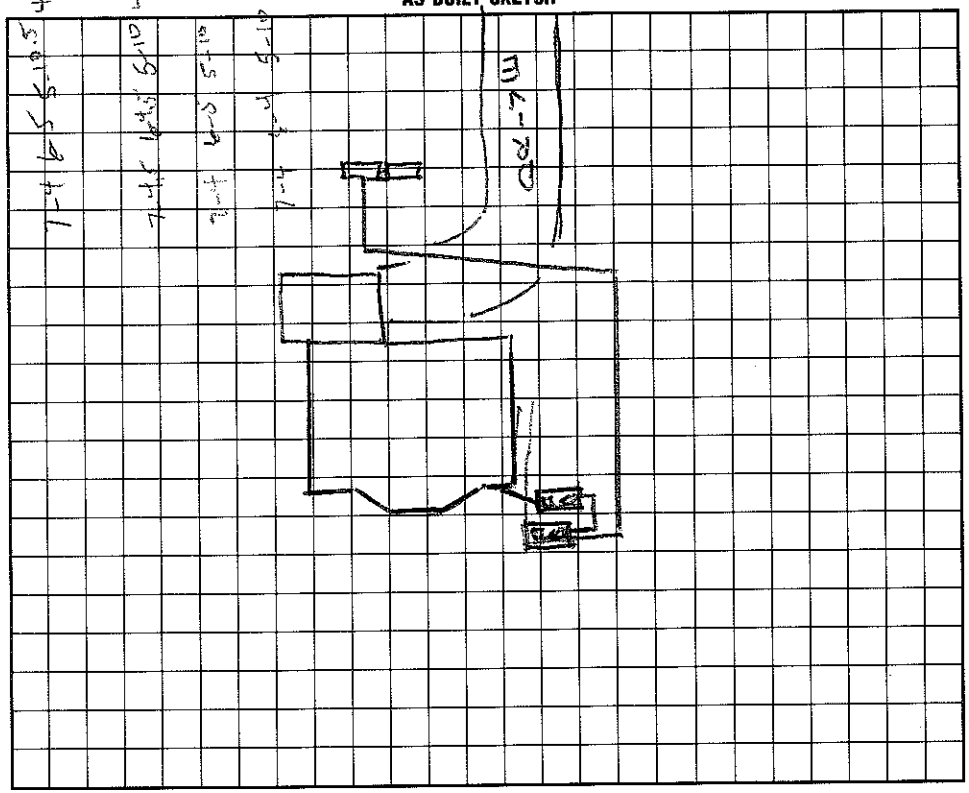

I understand that this permit can be suspended or revoked if any false information is supplied toward securing the permit/any unauthorized changes are made to the site/any unauthorized changes are made in the installation of the system. Improvement Permit is valid for 60 months from date of issuance.

Signed: * Ray Short

Improvement Permit by: Wesley Sparks RS. date 1/15/97

Existing System Inspection by: Wesley Sparks RS date 1/15/97

Installed by: F J Erwin

Certificate of Completion by: Wesley Sparks RS. date 3/10/97

Operation Permit by: Wesley Sparks RS date 3/10/97

Health Dept. Copy

HEALTH DEPT. COPY: WHITE INSPECTION COPY (FINAL): GREEN OWNER COPY (FINAL): YELLOW INSPECTION COPY (INITIAL): PINK OWNER COPY (INITIAL): GOLD