IREDELL COUNTY HEALTH DEPARTMENT

paid 125.00 DT 2100

STATESVILLE 704-878-5305 MOORESVILLE 704-664-5281

IMPROVEMENT PERMIT / AUTHORIZATION TO CONSTRUCT / OPERATION PERMIT / EXISTING SYSTEM INSPECTION

PERMIT# 091547 PIN# 4639133578 DATE 8/23/00

OWNER OR CONTRACTOR Otto Gutenson PHONE: Business _____ Home (704) 663-4767

ADDRESS 279 Beaten Path Mooresville NC 28117

LOCATION Perth, L Fern Hill, R Ball Finch, 5th on Lt

SUBDIVISION Beacon Pt BLOCK / SECTION — LOT 21 LOT AREA 0.99 AC SITE CLASS. PS DESIGN FLOW 480 L.T.A.R. 0.25

Septic Tank: 1000 Gallons; STB 312 Date 10-26-00
Pump Tank: 1000 Gallons; PT 283 Date 7-25-00
Pump Make: Myers Model ME 50 Serial No. 1/2 HP
Nitrification Field: No Fields 1 Square Feet 1440 Linear Feet 480
No Lines 6 @ 80 Trench Width 36" Max Trench Bottom Depth 36" Gravel Depth —

☒ New System ☐ Repair System Type: I, II, III, IV, V, VI
System Description: PM - 25% Reduction
Repair System Description: LPPPBS
Maintenance Agreement Required: ☐ Yes ☒ No

☒ House/Mod. Home No. Bedrooms 4
☐ Mobile Home No. Bathrooms 2½
☐ Business No. Employees ____
☐ Other


☐ Slab ☐ Crawl Space ☒ Basement w/plumbing ☐ Basement wo/plumbing

Water Supply:
☐ Individual
☐ Public
☒ Community


Comments:/Conditions:

Comments:/Conditions: Grey Filter (Zabal) Tanks & lines) Checked 12/6/2000.

INITIAL SITE SKETCH

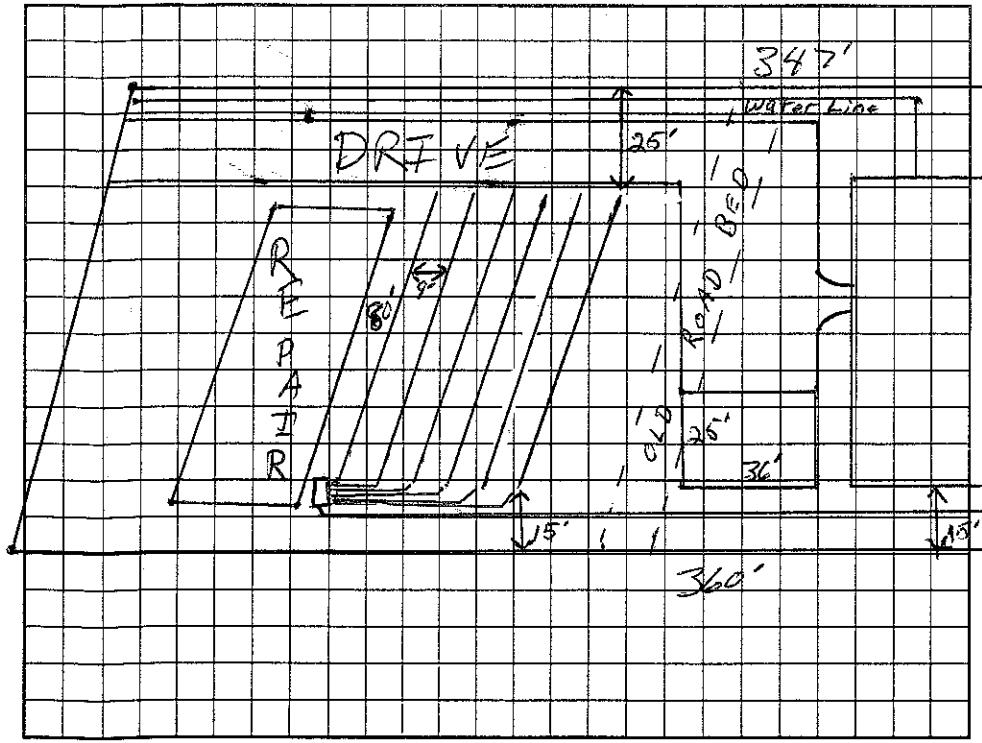

AS BUILT SKETCH

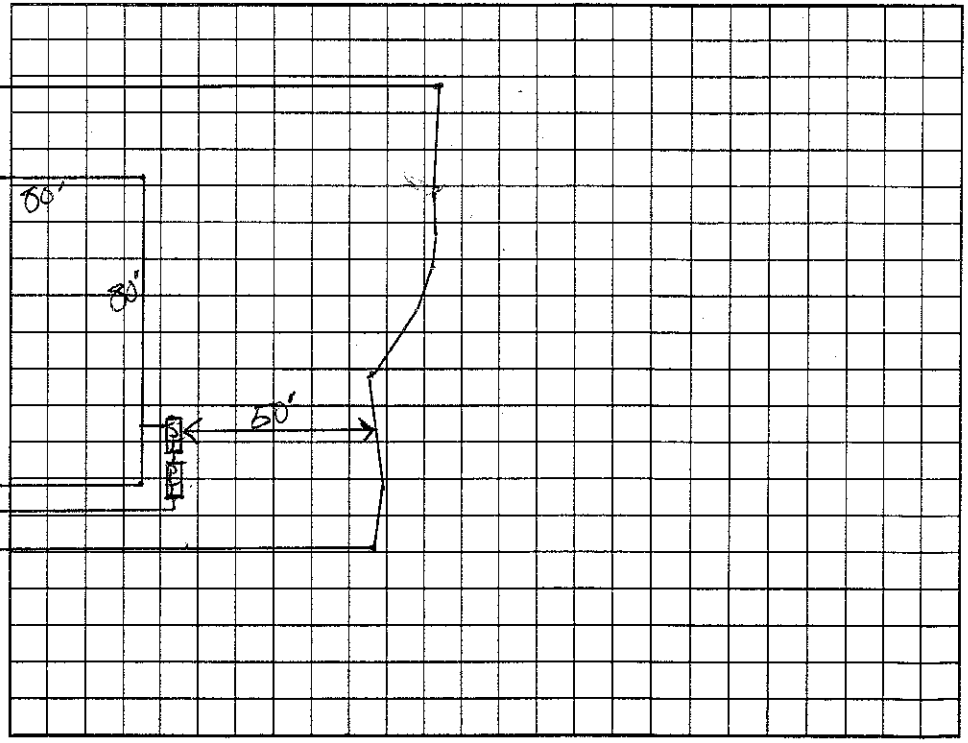

Permit can be suspended or revoked if any false information is supplied toward securing the permit/any unauthorized changes are made to the site/any unauthorized changes are made in the installation of the system. Improvement Permit with plat valid without expiration. Improvement Permit with site plan valid for sixty months. Authorization to Construct is valid for a period equal to that of Improvement Permit – not to exceed sixty months.

Signed: _____ date 9/14/00 Installed by: R & H

Improvement Permit by: _____ RS date 8/23/00 Operation Permit by: _____ RS date 3/26/2001

Authorization to Construct by: _____ RS date 8/23/00 Existing System Inspection by: _____ date _____

HEALTH DEPT. COPY: WHITE OWNER COPY (FINAL): YELLOW OWNER COPY (INITIAL): PINK